### **BOARD OF PUBLIC WORKS AND SAFETY** (Form B-01-2012) **Agenda Request Form**

Organizations and individuals are asked to submit a request form and supporting documents to be placed on the agenda. You will be contacted by the City confirming the date of the meeting in which your request will be heard. Please make sure that your contact information is accurate in case we need to get in touch with you. The Board of Works meets on the 1st and 3rd Monday of each month at 5:00 p.m. in City Hall located at 70 E. Monroe Street.

Data Oak	!44I -	Lub. 40, 0004	N/4:	D-4	A 5 0004				
Date Sub	omittea:	July 16, 2024	Meeting	Date:	August 5, 2024				
Contact Information:									
Request	ed by:	Mark Richards							
On Beha	On Behalf of Organization or Individual: Department of Planning & Engineering								
Telephoi	ne:	317-736-3631							
Email ad	dress:	mrichards@franklin.in.	gov						
Mailing A	Address:	70 E. Monroe Street, F	ranklin, IN 46	3131					
Describe	Request:								
Request Center P	• •	nd execution of Change	Orders 1 and	2 for th	e Active Adult				
List Sup	List Supporting Documentation Provided:								
Change (	Change Order Summary								
Change (	Change Order 1								
Change C	Change Order 2								
Who will	Who will present the request?								
Name:	Mark Richa	ards	Telephone:	317-73	86-3631				

In order for an individual and/or agency to be considered for new business on the Board of Works agenda, this reservation form and supporting documents must be received in the Mayor's office no later than 4:00 p.m. on the Wednesday before the meeting.

### Franklin Active Adult Center Project Change Order Summary

Original Contract Price: \$4,744,616.00

				Date	Adjusted Contract
Date Rec'd	CO#	Description	Cost	Approved	Amount
7/16/2024	1	Flooring material change	\$ (6,482.37)		\$ 4,738,133.63
7/16/2024	2	Building plan review changes	\$ 5,295.75		\$ 4,743,429.38

### Change Order # Between Dewees Construction Inc. and Owner Contract Number: 24-102 Change Order # One

This change order, made this 7/8	8/2024 by and between:		
<b>General Contractor</b>		Owner	
DeWees Construction Inc.		City of Franklin	
(hereinafter called Contractor)		(hereinafter called Owner)	
35 N. Baldwin St. (PO Box 691)	)	70 E Monroe	
Bargersville, IN 46106		Franklin, IN 46131	
ATTN: William H. Dewees			
Phone: 317-422-1654			
Fax: 317-422-5142			
Project:			
Active Adult Center			
160 E Adams St			
Franklin, IN 46131			
Reference: Materials and Lal	bor to:		
Tile credit based off PR-02			-\$6,482.37
		_	
Total	-		-\$6,482.37
	related thereto, and for performan	n full for all costs and markup directly or indirectly nce for this change within the time frame stated.	
Original contract Price			\$4,744,616.00
Amount of this contract Chan	ige Order		-\$6,482.37
Revised contract Amount, inc	cluding this contract C	change order	\$4,738,133.63
		are satisfactory and hereby accepted. All work to be performed under	
same terms and conditions as specified in o		ipulated.	
Not valid until signed by both partie	es e		
DeWees Construction		City of Franklin	
Company		Owner	
By:	Date	Ву:	Date

7/8/2024 Page 1 of 1 Initials

### **Marcy Stewart**

From:

Dennis Haynes

Sent:

Tuesday, July 2, 2024 4:28 PM

To:

Sam Miller

Cc: Subject: Bill Dewees; Marcy Stewart Active Adult Center PR-02

Attachments:

PR-02 Cost Summary 7-2-24.pdf

Sam,

Please find the cost comparison attached. Please review and advise. Thanks.

- Original bid on bid date = \$86,900.00
- PR-02 Flooring quote = \$49,166.79
- PR-02 Stagestep Dance Floor quote = \$5,032.09
- PR-02 Labor quote to install = \$26,218.75

PR-02 Total cost = \$80,417.63

### Net Savings = \$6,482.37

Dennis Haynes DeWees Construction, Inc. P.O. Box 691 Bargersville, IN 46106  $\mathcal{F} = (317422-1654)$   $\mathcal{F} = (317)422-5142$  $\mathcal{C} = (317)491-4429$ 

dennis@deweesconstruction.com

BID DAY BIS



FAX (317) 356-2260 420 RAWLES COURT · INDIANAPOLIS, IN 46229 · TELEPHONE (317) 352-1581

**TO:** Estimating

FROM: Steven M McIlree

**DATE:** May 13, 2024

### WE PROPOSE A BID FOR THE FOLLOWING

**PROJECT:** Franklin – Active Adult Center

THIS IS A COMBINED BID:

INDIVIDUAL BID: X

Supply and install carpet, lvt, floor and wall tile, rubber base, and transitions as noted on plan

I HAVE SEEN ADDENDUMS: 1, 2

EXCLUSIONS: NO MAJOR PREP, NO WAXING OF VINYL TILE, NO DEMOLITION, NO SEALING OF CERAMIC TILE, NO BACKERBOARD, NO WALK-OFF MAT SYSTEMS (METAL OR ANCHORED) NO CAULKING, NO REMOVAL/DEMOLITION/MITIGATION OF SEALED/STAINED/EPOXY FLOOR. NO SHOTBLASTING/PRIMING/MECHANICAL PREP. NO FLOOR PROTECTION.

ADDITIONAL NOTE: ANY DEMOLITION COMPLETED BY OTHERS MUST REMOVE ALL FLOORING MATERIALS INCLUDING THINSETS AND ADHESIVES.

THIS PRICE IS A NON-UNION BID

\$86,900.00

SIGNED: Steven M Mallree

PR-02 PROPOSED MATERIAL



### PROSOURCE OF INDIANAPOLIS 6822 HILLSDALE CT INDIANAPOLIS, IN 46250

Telephone: 317-915-8200 Fax: 317-915-8205

Page 1

ES41290

#### **ESTIMATE**

Sold To	Ship To
DEWEES, CONSTRUCTION 35 N BALDWIN BARGERSVILLE, IN 46106	
Home: 3174221654 Business: 3174221654	

Order Date		Purchase	Order		Order N	lumber
06/19/24		FRANKLII	N ADULT CENTER FINAL		ES4129	007
Style/Item	Color/Descript	ion	Quantity	Units	Price	Total
ALLIUM 18X36	67511 STONE	PATH	864.00	SF	6.88	5,944.32
ACCENTUATE 24X24	45206 BARK (	CLOTH	780.00	SF	5.32	4,149.60
C-EX ADHESIVE	4 GAL PAIL 13 SY/4 GAL SPI RATE		2.00	EA	120.00	240.00
TREELINE 12 MIL	007811 CLOV	E	3,028.47	SF	1.92	5,814.66
TREELINE 12 MIL	00837 CHEST	NUT	2,515.17	SF	1.92	4,829.13
4200 RESILIENT ADHESIVE	4 GAL PAIL 17 SF/1 GAL SPE RATE		7.00	EA	200.00	1,400.00
MANDALAY 6"	MW-XX-H6 80	FAWN	480.00	LF	6.66	3,196.80
4" COVE BASE	29 MOONRO	CK	960.00	LF	0.84	806.40
4" COVE BASE	BLACK		120.00	LF	0.84	100.80
ADHESIVE	30 OZ CARTE 225 LF/CARTI		7.00	EA	5.51	38.57
WELCOME II	31557 STERL	ING	191.88	SF	6.08	1,166.63
CARPET TILE ADHESIVE	4 GAL PAIL S RATE 28-33 S		1.00	EA	115.00	115.00

- 07/02/24 Sales Representative(s):	Material:	3:55PM <sup>-</sup> 49,166.79
KIM MURPHY	Service:	0.00
KINI MOKI III	Misc. Charges:	0.00
	Sales Tax:	3,441.68
	Misc. Tax:	0.00
	QUOTE TOTAL:	\$52,608.47



### PROSOURCE OF INDIANAPOLIS 6822 HILLSDALE CT INDIANAPOLIS, IN 46250

Telephone: 317-915-8200 Fax: 317-915-8205

Page 2

ES412907

### **ESTIMATE**

Sold To	Ship To
DEWEES, CONSTRUCTION 35 N BALDWIN BARGERSVILLE, IN 46106	
Home: 3174221654 Business: 3174221654	

Order Date	Purchase			Order N	
06/19/24	FRANKLI	FRANKLIN ADULT CENTER FINAL		ES41290	)7
Style/Item	Color/Description	Quantity	Units	Price	Total
COLOR WHEEL CLASSIC 6X6 FLOOR TILE	ARCHITECTURAL GRAY GLOSSY 109	50.00	SF	4.47	223.50
COLOR WHEEL CLASSIC 6X6 FLOOR TILE	ALMOND MATTE X735	425.00	SF	4.47	1,899.75
COLOR WHEEL CLASSIC 6X6 FLOOR TILE	GARDEN SPOT GLOSSY 0141	25.00	SF	4.47	111.75
KEYSTONES STRAIGHT JOINT 2X2 DM 12X24 MT GRP2	ARCHITECT GRAY MATTE	130.00	SF	5.71	742.30
KEYSTONES STRAIGHT JOINT 2X2 DM 12X24 MT GRP2	CYPRESS MATTE	72.00	SF	5.71	411.12
UNICHE RECTIFIED 12X24 MATTE	BEIGE CHIARO	464.80	SF	7.20	3,346.56
UNICHE RECTIFIED 12X24 MATTE	BIANCO	1,243.34	SF	7.20	8,952.05

07/02/24	Material:	3:55PM <sup>-</sup> 49,166.79
KIM MURPHY	Service:	0.00
	Misc. Charges:	0.00
	Sales Tax:	3,441.68
	Misc. Tax:	0.00
	QUOTE TOTAL:	\$52,608.47



### PROSOURCE OF INDIANAPOLIS 6822 HILLSDALE CT INDIANAPOLIS, IN 46250

Telephone: 317-915-8200 Fax: 317-915-8205

Page 3

ES412907

### **ESTIMATE**

Sold To	Ship To
DEWEES, CONSTRUCTION 35 N BALDWIN BARGERSVILLE, IN 46106	
Home: 3174221654 Business: 3174221654	

Order Date 06/19/24		chase Order NKLIN ADULT CENTER FINAL		Order ES41	Number 2907
Style/Item	Color/Description	Quantity	Units	Price	Total
UNICHE RECTIFIED 12X24 MATTE	BEIGE CHIARO	371.84	SF	7.20	2,677.25
LHT PLUS THINSET WHITE*** - N/A	WHITE	59.00	EA	27.73	1,636.07
SPECTRALOCK PRO PREMIUM EPOXY GROUT FULL UNIT 1X PAIL EACH PART A AND PART B	XXX	8.00	EA	141.16	1,129.28
LATICRETE PERMACOLOR SELECT 25LB*** - 25 LB	ZLC2600-0025-2	5.00	EA	47.05	235.25

Due to Volatile Market Conditions, Quoted Prices Are Good for 48 Hours from Date of Quote

07/02/24		3:55PM <sup>-</sup>
Sales Representative(s):	Material:	49,166.79
KIM MURPHY	Service:	0.00
	Misc. Charges:	0.00
	Sales Tax:	3,441.68
(	Misc. Tax:	0.00
	QUOTE TOTAL:	\$52,608.47
4		



### PROSOURCE OF INDIANAPOLIS 6822 HILLSDALE CT INDIANAPOLIS, IN 46250

Telephone: 317-915-8200 Fax: 317-915-8205

Page 4

ES412907

**ESTIMATE** 

Sold To		Ship To
DEWEES, CONSTRUC 35 N BALDWIN BARGERSVILLE, IN 4		
Home:3174221654	Business: 3174221654	

Order Date	Purchase Order		Order Numb	er
06/19/24	FRANKLIN ADU	LT CENTER FINAL	ES412907	
Style/Item	Color/Description	Quantity Units	Price	Total

Invoices must be paid in full to pick up partial orders. Remaining material must be picked up within 30 days. Material will be forfeited after 90 days. Installer and/or end user is responsible for inspection of material prior to install for defects. The accuracy of the above sizes & quantities are the responsibility of member or client. Special order items are not cancelable or returnable. A 25% restock fee may be charged for any returned "stocked" items.

07/02/24		3:55PM -
Sales Representative(s):	Material:	49,166.79
KIM MURPHY	Service:	0.00
	Misc. Charges:	0.00
	Sales Tax:	3,441.68
	Misc. Tax:	0.00
	QUOTE TOTAL:	\$52,608.47

PR-02 PROPOSEDMATERIAL

### **Invoice**

### Stagestep Inc.

Stagestep 4701 Bath Street Bldg 46B Philadelphia, PA 19137 Phone: 215-636-9000

Email: sales@stagestep.com

Order#	Date
86368	06/19/2024



#### Bill To:

Dewees Construction Inc.

Dennis Haynes 35 N. Baldwin St. Bargersville, IN 46

Customer: Dewees Construction Inc.

Ship To:

Dewees Construction Inc.

Dennis Haynes 35 N. Baldwin St. Bargersville, IN 46

Contact: Dewees Construction Inc.

**Notes:** 317-491-4429

add liftgate Dennis Haynes

dennis@deweesconstruction.com

Sales Rep	Payment Terms	FOB Point	Carrier	Ship Service	Date Scheduled
dkennedy	Prepay	Origin	Old Dominion		06/12/2024

Item #	Туре	Number	Description	Unit Price	Qty Ordered	Total Price
1	Sale	11051000 (39 ft)	Dancestep Plus Black - 11051000 area size = 16 x 39	\$49.00	28.42 SY	\$1,392.58
2	Sale	11051000 (39 ft)	Dancestep Plus Black - 11051000	\$49.00	28.42 SY	\$1,392.58
3	Sale	11051000 (20 ft)	Dancestep Plus Black - 11051000	\$49.00	14.57 SY	\$713.93
4	Sale	13021040	Stagestep Adhesive	\$216.00	2 Bukt	\$432.00
5	Sale	13012050	Bone Dry Plus Liquid Vapor Barrier	\$297.00	1 Bukt	\$297.00
6	Sale	14011010	ProClean 1 gal	\$38.00	1 ea	\$38.00
7	Shipping	19201000	Shipping and Handling Charge	\$766.00	1 ea	\$766.00

Subtotal:	\$5,032.09
Sales Tax:	\$0.00
Total:	\$5,032.09

ESTIMATES ARE GOOD FOR THIRTY (30) DAYS.
Shipping is door to door service only. There is no inside delivery.
Dye lots may vary and floor patterns may vary within dye lots.
PLEASE READ ADDITIONAL POLICIES: https://www.stagestep.com/important-policies/
For any questions call 215-636-9000 or email sales@stagestep.com

PR-02 PROPOSED LABOR

From:

Trent Ramsey <trentramsey@yahoo.com>

Sent:

Monday, June 24, 2024 9:47 AM

To:

Dennis Haynes

Subject:

**Dennis Haynes** 

Re: City of Franklin Active Adult Center

- 833sf (CPT1) Tarkett G0043 Allium 18" x 36" Color: 67511 Stone Path \$450
- 773sf (CPT2) Tarkett 04255 Accentuate 24" x 24" Color: 45206 Bark Cloth \$450
- 3,005sf (LVT1) Patcraft Treeline 12mil Style 1710V 7" x 48" Color: 007811 Clove V2 \$3750.25
- 2,503sf (LVT2) Patcraft Treeline 12mil Style 1710V 7" x 48" Color: 00837 Chestnut V2 \$3128.50
- 167sf (WLK1) Shaw Contract Welcome II 24" x 24" Color: 31557 Sterling \$100
- 702sf (SF1) StageStep Dance Plus Color: Black \$1400
- 480lf (RCB1) Johnsonite Tarket 6" Mandalay MW-XX-H6 Color: 80 Fawn \$700
- 864If (RCB2) Johnsonite Tarkett 4" Traditional Wall Base Color: 29 Moon Rock WG \$864
- 91lf (RCB3) Johnsonite Tarkett 4" Traditional Wall Base Color: Black \$91
- 50sf (CT1) Daltile Color Wheel Classic 6" x 6" Glossy Color: Architectural Gray 109 \$250
- 421sf (CT2) Daltile Color Wheel Classic 6" x 6" Matte Color: Almond X735 \$2105
- 17sf (CT3) Daltile Color Wheel Classic 6" x 6" Glossy Color: Garden Spot 0141 \$100

- 🕇 130sf (CT1F) Daltile Keystone Classic 2" x 2" Mosaic Color: Architectura Gray D109 \$650
- 71sf (CT3F) Daltile Keystone Classic 2" x 2" Mosaic Color: Cypress D452 \$355
- 465sf (PCT1) Daltile Stone Look 12" x 24" Color: MZ Uniche SS UN11 Beige Chiaro \$2325
- 1,236sf (PCT2) Daltile Stone Look 12" x 24" Color: MZ Uniche SS ON10 Bianco \$6180
- 364sf (PCTB1) Daltile Stone Look 12" x 24" Color: MZ Uniche SS UN11 Beige Chiaro \$1820
- Minimal prep \$1500
- Total \$26,218.75

# Change Order # Between Dewees Construction Inc. and Owner Contract Number: \_\_\_\_\_24-102 \_\_\_ Change Order # Two

This change order, made this 7/16/202	24 by and between:		
<b>General Contractor</b>		Owner	
DeWees Construction Inc.		City of Franklin	
(hereinafter called Contractor)		(hereinafter called Owner)	
35 N. Baldwin St. (PO Box 691)		70 E Monroe	
Bargersville, IN 46106		Franklin, IN 46131	
ATTN: William H. Dewees		0	
Phone: 317-422-1654		0	
Fax: 317-422-5142		0	
Project:			
Active Adult Center			
160 E Adams St			
Franklin, IN 46131			
Reference: Materials and Labor to:			
PR-03			
Add a sidewalk from the SW exit of the	Events Room South	n to Water Street	
Add maximum occupancy allowed sign			
Add exit sign and emergency wall pack	light in Passage 32		
Add exterior horn strobe on South wall	at Game Room 15 &	& pull station at water/fire protection 4	
Total			\$5,295.75
It is understood and agreed that this adjustment constitute attributable to this change, or for all delays related there we hereby agree to make the change(s) specified below	eto, and for performance for		
Original contract Price			\$4,744,616.00
Net change by previous contract Cha	ange Orders		-\$6,482.37
Contract Amount Prior to this Change	-		\$4,738,133.63
Amount of this contract Change Orde			\$5,295.75
Revised contract Amount, including t		ge order	\$4,743,429.38
ACCEPTED - The above prices and specifications of same terms and conditions as specified in original control Not valid until signed by both parties			ormed under
DeWees Construction			
Company		Owner	
Dv.	Date	Dv.	Date
By:	Date	Ву:	Date

7/16/2024 Page 1 of 1 Initials

### **Marcy Stewart**

From:

Mark Richards < mrichards@franklin.in.gov>

Sent:

Tuesday, July 16, 2024 1:47 PM

To:

Sam Miller; Dennis Haynes Bill Dewees; Marcy Stewart

Cc: Subject:

RE: Active Adult Center PR-03

Sam,

The City is good with this. Please prepare the CO and get it to me. If I have it by July 31 at noon, I can have it on the August 5<sup>th</sup> BPW&S agenda for approval.

Thanks!

Mark

From: Sam Miller <SMiller@cripe.biz> Sent: Tuesday, July 16, 2024 12:52 PM

To: Dennis Haynes <dennis@deweesconstruction.com>

Cc: Bill Dewees <bill@deweesconstruction.com>; Marcy Stewart <marcy@deweesconstruction.com>; Mark Richards

<mrichards@franklin.in.gov>

Subject: RE: Active Adult Center PR-03

Dennis; Seems reasonable here.

Mark; Ok with you?

Please go ahead and prep the C.O. Thanks, Sam

From: Dennis Haynes < dennis@deweesconstruction.com >

Sent: Tuesday, July 16, 2024 12:36 PM To: Sam Miller <SMiller@cripe.biz>

Cc: Bill Dewees < bill@deweesconstruction.com >; Marcy Stewart < marcy@deweesconstruction.com >

Subject: Active Adult Center PR-03

Sam,

Here is the breakdown for PR-03.

• Concrete: CSM Concrete = \$2,500.00

Signage: Riley Signs = \$200.00

Electric: Huff Electric = \$850.00

Fire Alarm: Koorsen = \$455.00

Labor = \$600.00

Total Material & Labor = 4,605.00 Mark-Up = \$690.75

### Total Amount for PR-03 = \$5,295.75

Dennis Haynes
DeWees Construction, Inc. F.U. Box 691Bargersville, IN 46106 F = (317422-1654 F = (317)422-5142 C = (317)491-4429dennis@deweesconstruction.com



9339 Priority Way West Suite, 100 Indianapolis, IN 46240 **317-844-6777** FAX: 317-706-6464 www.cripe.biz

OWNER
ARCHITECT
INTERIOR DESIGNER
CONTRACTOR
FIELD
OTHER

### **PROPOSAL REQUEST**

Sam Miller

PROJECT:	PROPOSAL REQUEST NUMBER:	PR-03
Franklin Active Adult Center 160 E. Adams Street Franklin, IN 46131	DATE OF ISSUANCE:	07/05/2024
OWNER:	CONTRACT FOR:	General Construction
City of Franklin, Parks & Recreation 396 Branigin Blvd.	CONTRACT DATE:	12/1/2022
Franklin, IN 46131	ARCHITECT'S PROJECT NO.	0210036-10100
TO CONTRACTOR: DeWees Construction 35 N. Baldwin St. Bargersville, IN 46106	ARCHITECT: Cripe A+E 9339 Priority Way West Drive, Suite 100 Indianapolis, IN 46240	
Please submit an itemized proposal for changes in the Col Documents described herein. Submit proposal within 5 bu anticipate submitting your proposal. THIS IS NOT A CHANGE ORDER, A CONSTRUCTION C	siness days, or notify the Architect in writing of th	e date on which you
DESCRIBED IN THE PROPOSED MODIFICATIONS.	HANGE DIRECTIVE OR A DIRECTION TO PRO	JOEED WITH THE WORK
<u>Description:</u>		
Based on comments from the local building depattached narrative and drawings.	partment, please provide a cost to add i	tems indicated in the
Attachments:		
Sheets C201, C301, G002, A001, E201 and E301.		
ARCHITECT Cripe A+E		



Solutions by Design Since 1937

Telephone 317.844.6777

www.cripe.biz

3939 Priority Way South Drive, Suite 200, Indianapolis, Indiana 46240

### Franklin Active Adult Center

#### PR-03 Narrative:


Overview: PR-03 is a result of Franklin Building Department review and comments on the documents. Note there is also an attached spreadsheet with notes providing answers to comments and indicating revisions to drawings.


- 1. Civil:
  - a. Sheets C201 and C301: Add a sidewalk from the southwest exit of the Events Room south to Water Street.
- 2. Architectural:
  - a. Sheet G002: Provide signs as shown to call out maximum occupancy allowed in assembly spaces.
  - b. Sheet A001: Add sign detail as shown.
- 3. Electrical:
  - a. Sheet E201: Add exit sign and Emergency Wall Pack light in Passage 32.
  - b. Sheet E301: Add exterior horn strobe on south wall at Game Room 15 and Pull Station at Water/Fire Protection 04.


### Franklin AAC Building Department Review Comments

Responses Below: In same order as received from the City.

	A fire alarm manual pull station was added to Water/Fire Protection 04. See
1. Manual Pull alarm in sprinkler control room	E301 attached.
	The fire alarm control panel is located in room Elect. 12, shown in View 2
2. FCAP location?	on sheet E301 attached.
	The fire alarm control panel smoke detector is located in room Elect. 12,
3. Smoke detector in FCAP location	shown in View 2 on sheet E301 attached.
	Emergency lights are indicated with the "EM" suffix on the light fixture tag
	on sheet E201. All exterior egress doors are illuminated by an emergency
4. Exterior EM lights at exits	light fixture.
	A dual-head emergency wall pack was added to Passage 32 to provide
5. EM lights in corridor exiting "Events" room	emergency lighting while exiting Events 32. See E201 attached.
	An exit sign was added at the east end of the north corridor. See E201
6. Exit sign north corridor exiting East	attached.
7. Still need sprinkler plans and CDR	To follow from G.C.'s sprinkler contractor
8. Hard surface walkway to publicway southwest exit door (showing	Added to Site Plan C201 and Grading Plan C301.
landing only)	
9. Occupant load signs in Events, Auditorium, game room and	Added to notes on Life Safety Plan sheet G002 & an Occupancy Sign detail on
meeting library	A001.
10. I did not see the drinking fountain	See Alcove 07, north wall sheet A101N and P201, "EWC-1"
11. Exterior Horn/Strobe for water flow alarm	An exterior horn/strobe device was added to the Adams Street facing side of the building per Indiana Fire Code 903.4.2. See E301 attached.
	Lever handles are specified in 08 7100. See A702 for hardware sets. Yale 5300
	series locks are called for typically at interior doors. You can see an example
	here: https://www.build.com/yale-
	au5308ln/s1459838?utm_source=impact&utm_medium=affiliate&utm_campa
	ign=Bing+Rebates+by+Microsoft&PID=2003851&ClickID=Sf2WKRXnYzO3UcaV
	tDRh6Qb4UkC0a9T5Wyx50c0&irgwc=1&AdName=Logo&AdID=1141101&uid=3
12. All doors will need lever handles	436171

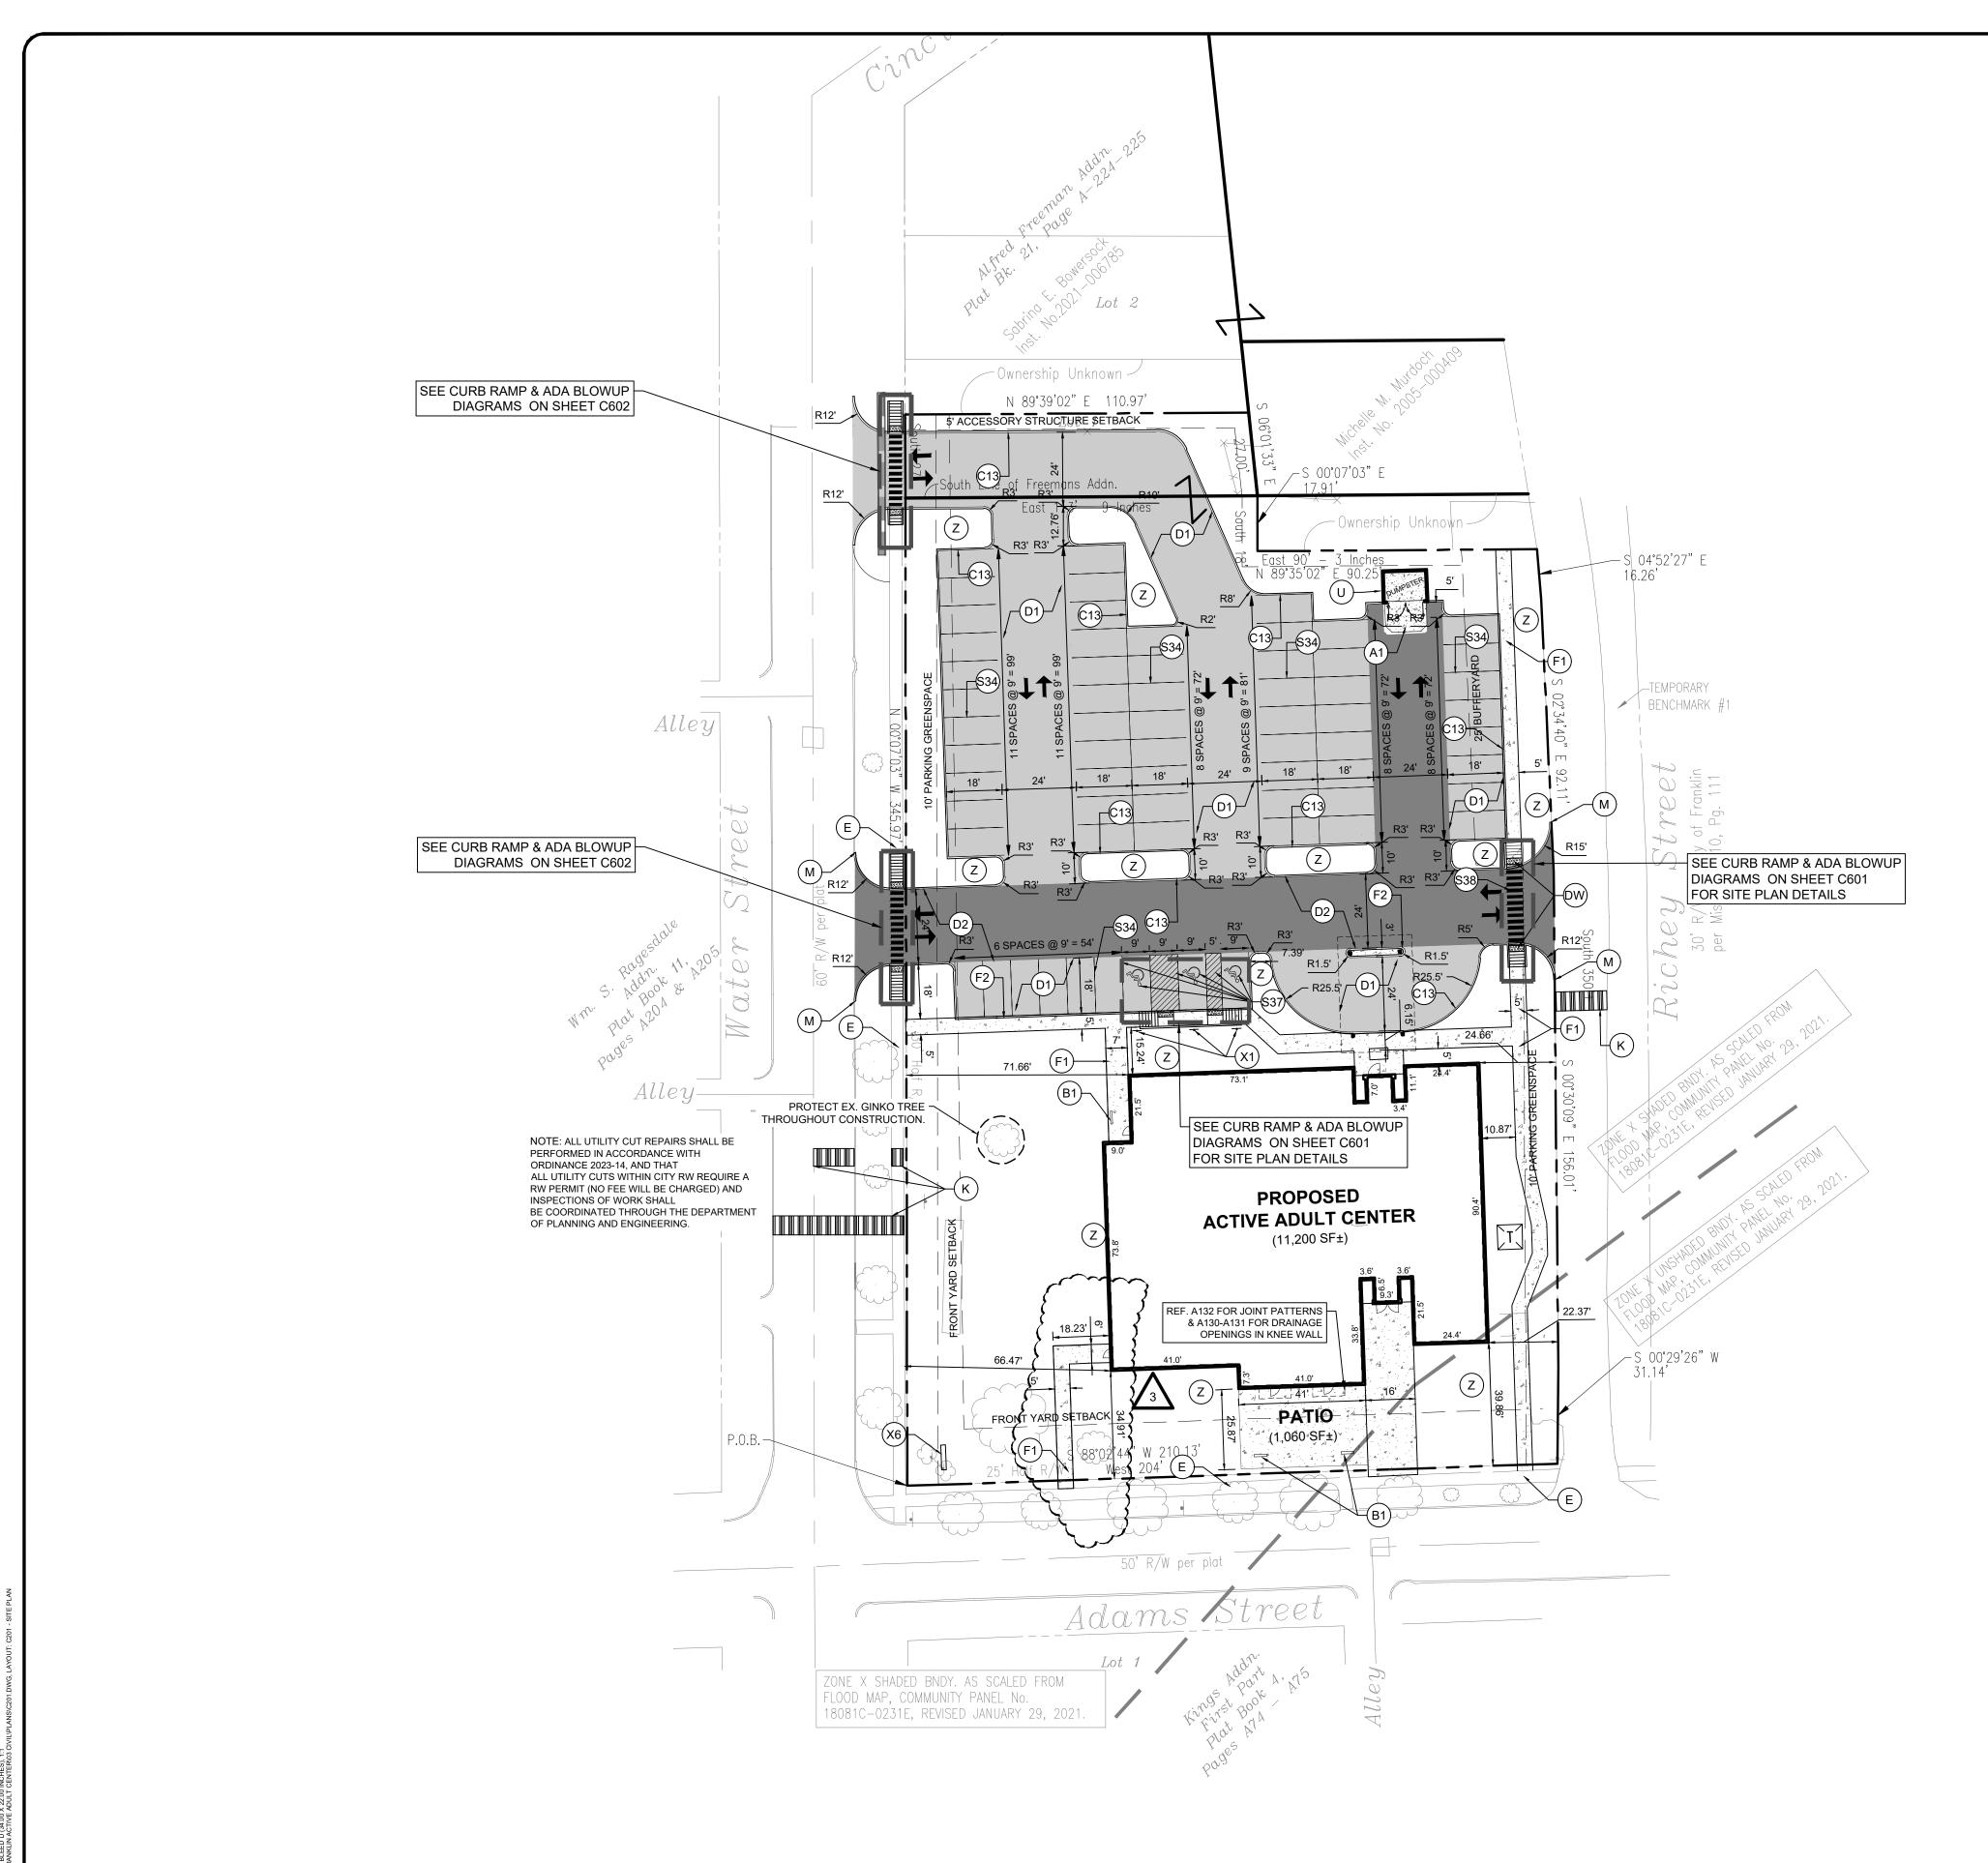

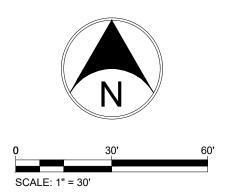

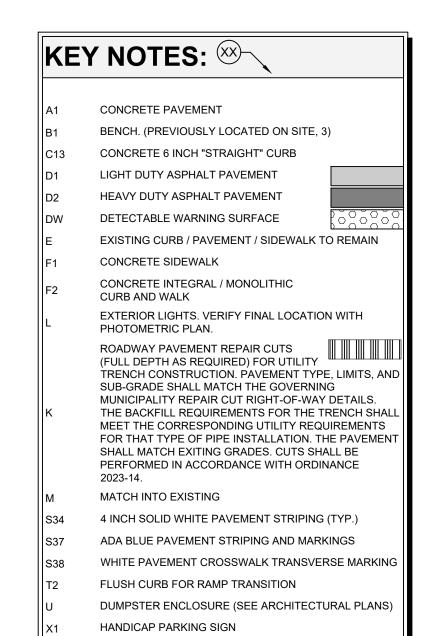

MONUMENT SIGN (REF. ARCH. PLANS)

LANDSCAPE AREA



CARMEL, INDIANA 46033
P: 317.324.8695 F: 317.324.8717
www.Fritz-Eng.com



6/27/2024	AF
4/17/2024	AF
3/27/2024	AF
DATE	BY
	4/17/2024 3/27/2024

GENERAL NOTES / LEGEND:



2 WORKING DAYS BEFORE YOU DIG.

PROJECT

# FRANKLIN ACTIVE ADULT CENTER

PROJECT LOCATION:

160 E. ADAMS ST.

FRANKLIN, INDIANA 46131

JOHNSON COUNTY

SECTION, TOWNSHIP, RANGE:

SW \(^{1}{4}\), S14, T12N, R3E

CRIPE

9339 PRIORITY WAY WEST, STE 100 INDIANAPOLIS, INDIANA 46240

PLAN DATE: 2/12/2024

DESIGN: CHECK: DRAW AF PROJECT NO.


2309006 SHEET NAME

SITE PLAN

SHEET NO.

C201

PRINTED BY: Ashton Fritz DATE: 7/2/2024 9:18 AM

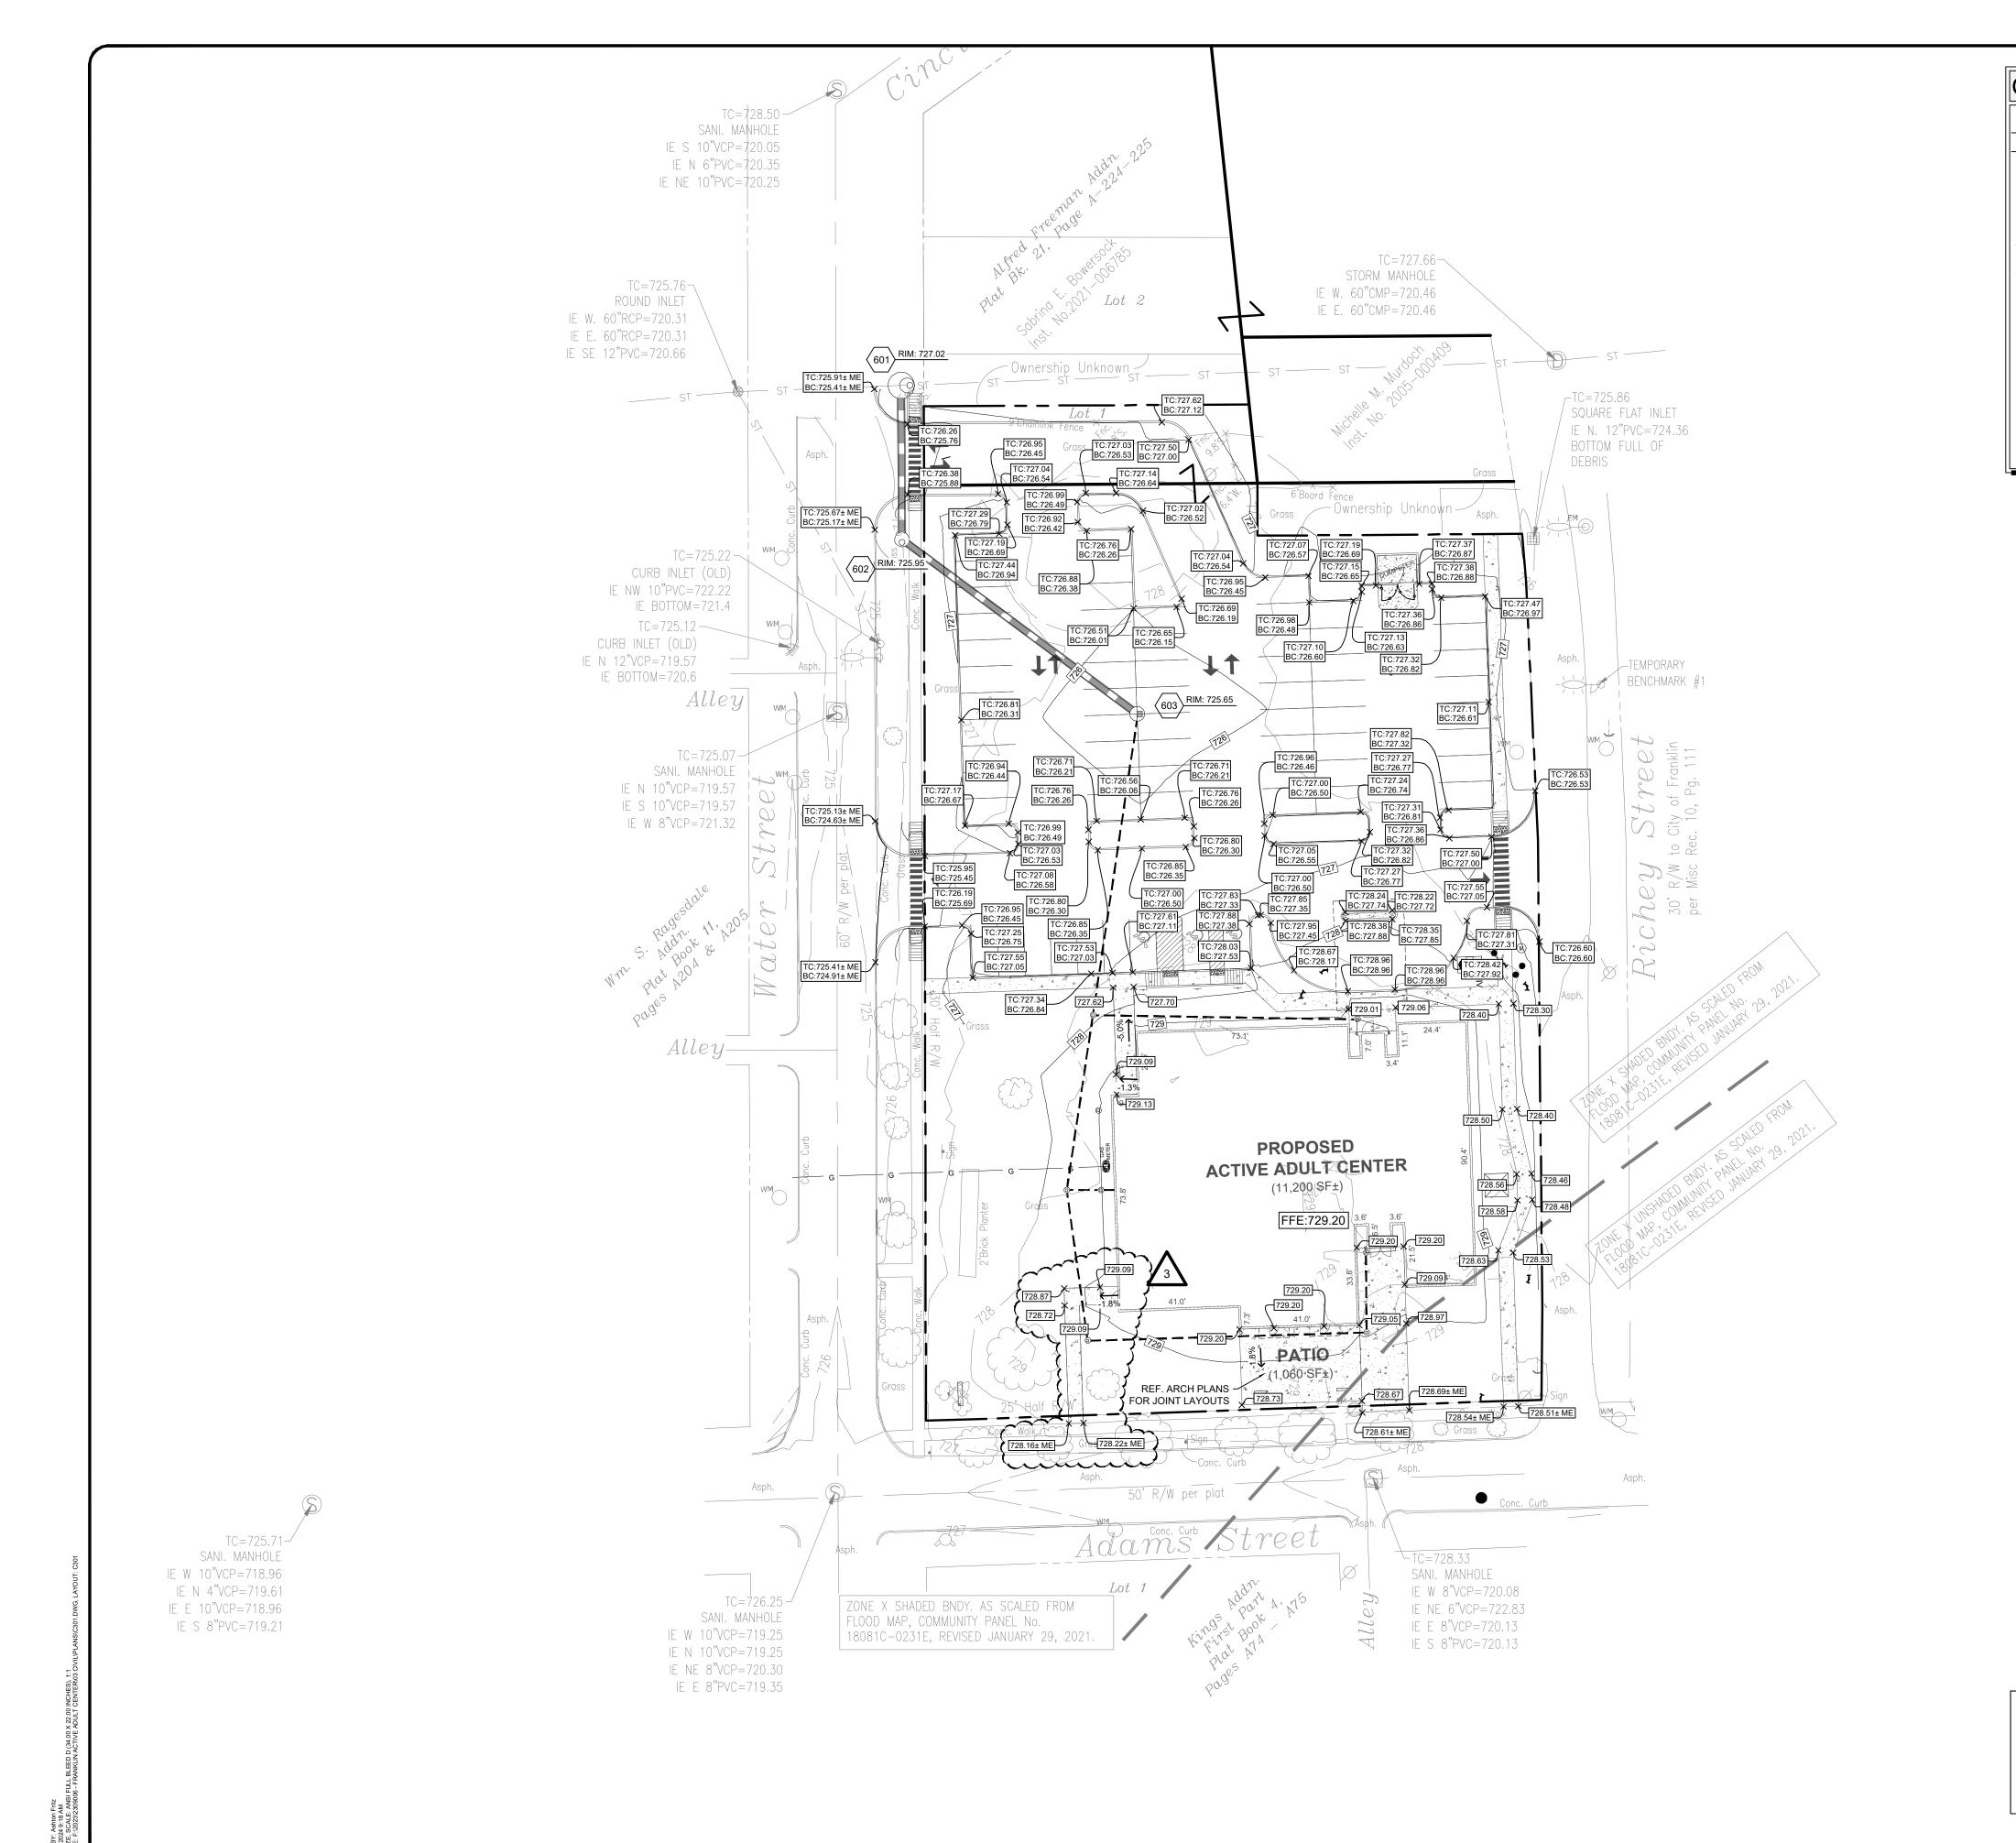

## **GRADING LEGEND:** ->---->-----> FLOW LINE, PAVEMENT

→ ··· FLOW LINE, SWALE / DITCH → FLOW DIRECTIONAL ARROW


— — — — GRADE BREAK LINE GRADING CONSTRUCTION LIMITS EXISTING CONTOURS.

"###" INDICATES ELEVATION. PROPOSED CONTOURS. "###" INDICATES ELEVATION. (XXX.XX) SPOT ELEVATIONS

> (£:XXX.XX) FLOW LINE ELEVATION (XXX.XX H.P.) HIGH POINT ELEVATION (XXX.XX L.P.) LOW POINT ELEVATION TC:XXX.XX TOP CURB ELEVATION BC:XXX.XX BOTTOM CURB ELEVATION

TW:XXX.XX) TOP WALL ELEVATION BW:XXX.XX BOTTOM WALL ELEVATION (XXX.XX RIM) CASTING RIM ELEVATION ME MATCH EXISTING GRADE / ELEVATION



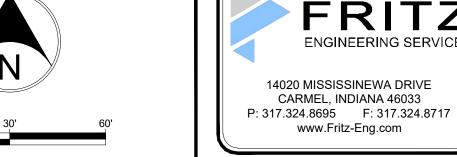



ENGINEERING SERVICES

14020 MISSISSINEWA DRIVE

CARMEL, INDIANA 46033

www.Fritz-Eng.com

PR-03 LOCAL BLDG/FD REVIEW	6/27/2024	AF
1.REV PER TECH REVIEW	3/27/2024	AF
REVISIONS AND ISSUES	DATE	BY

GENERAL NOTES / LEGEND:

"IT'S THE

Know what's below. Call before you dig. 2 WORKING DAYS BEFORE YOU DIG.

# FRANKLIN **ACTIVE ADULT** CENTER

PROJECT LOCATION: 160 E. ADAMS ST. FRANKLIN, INDIANA 46131 JOHNSON COUNTY SECTION, TOWNSHIP, RANGE: SW <sup>1</sup>/<sub>4</sub>, S14, T12N, R3E

CRIPE

9339 PRIORITY WAY WEST, STE 100 INDIANAPOLIS, INDIANA 46240

PLAN DATE: 2/12/2024

AF PROJECT NO.


2309006 SHEET NAME

**GRADING PLAN** 

C301

**SURVEY VERTICAL DATUM INFORMATION:** 

THE SURVEY AND THIS PROJECT ELEVATIONS ARE ESTABLISHED BASED ON THE NORTH AMERICAN VERTICAL DATUM OF 1988 (NAVD88). THE VERTICAL DATUM WAS ESTABLISHED BY THE SURVEYOR PER GLOBAL POSITIONING SYSTEM (GPS) OBSERVATIONS UTILIZING INCORS NETWORK AND GEOID18. THEREFORE, THE ELEVATIONS, CONTOURS AND GRADES SHOWN ON THIS SHEET AND PLAN SET ARE IN NAVD88.

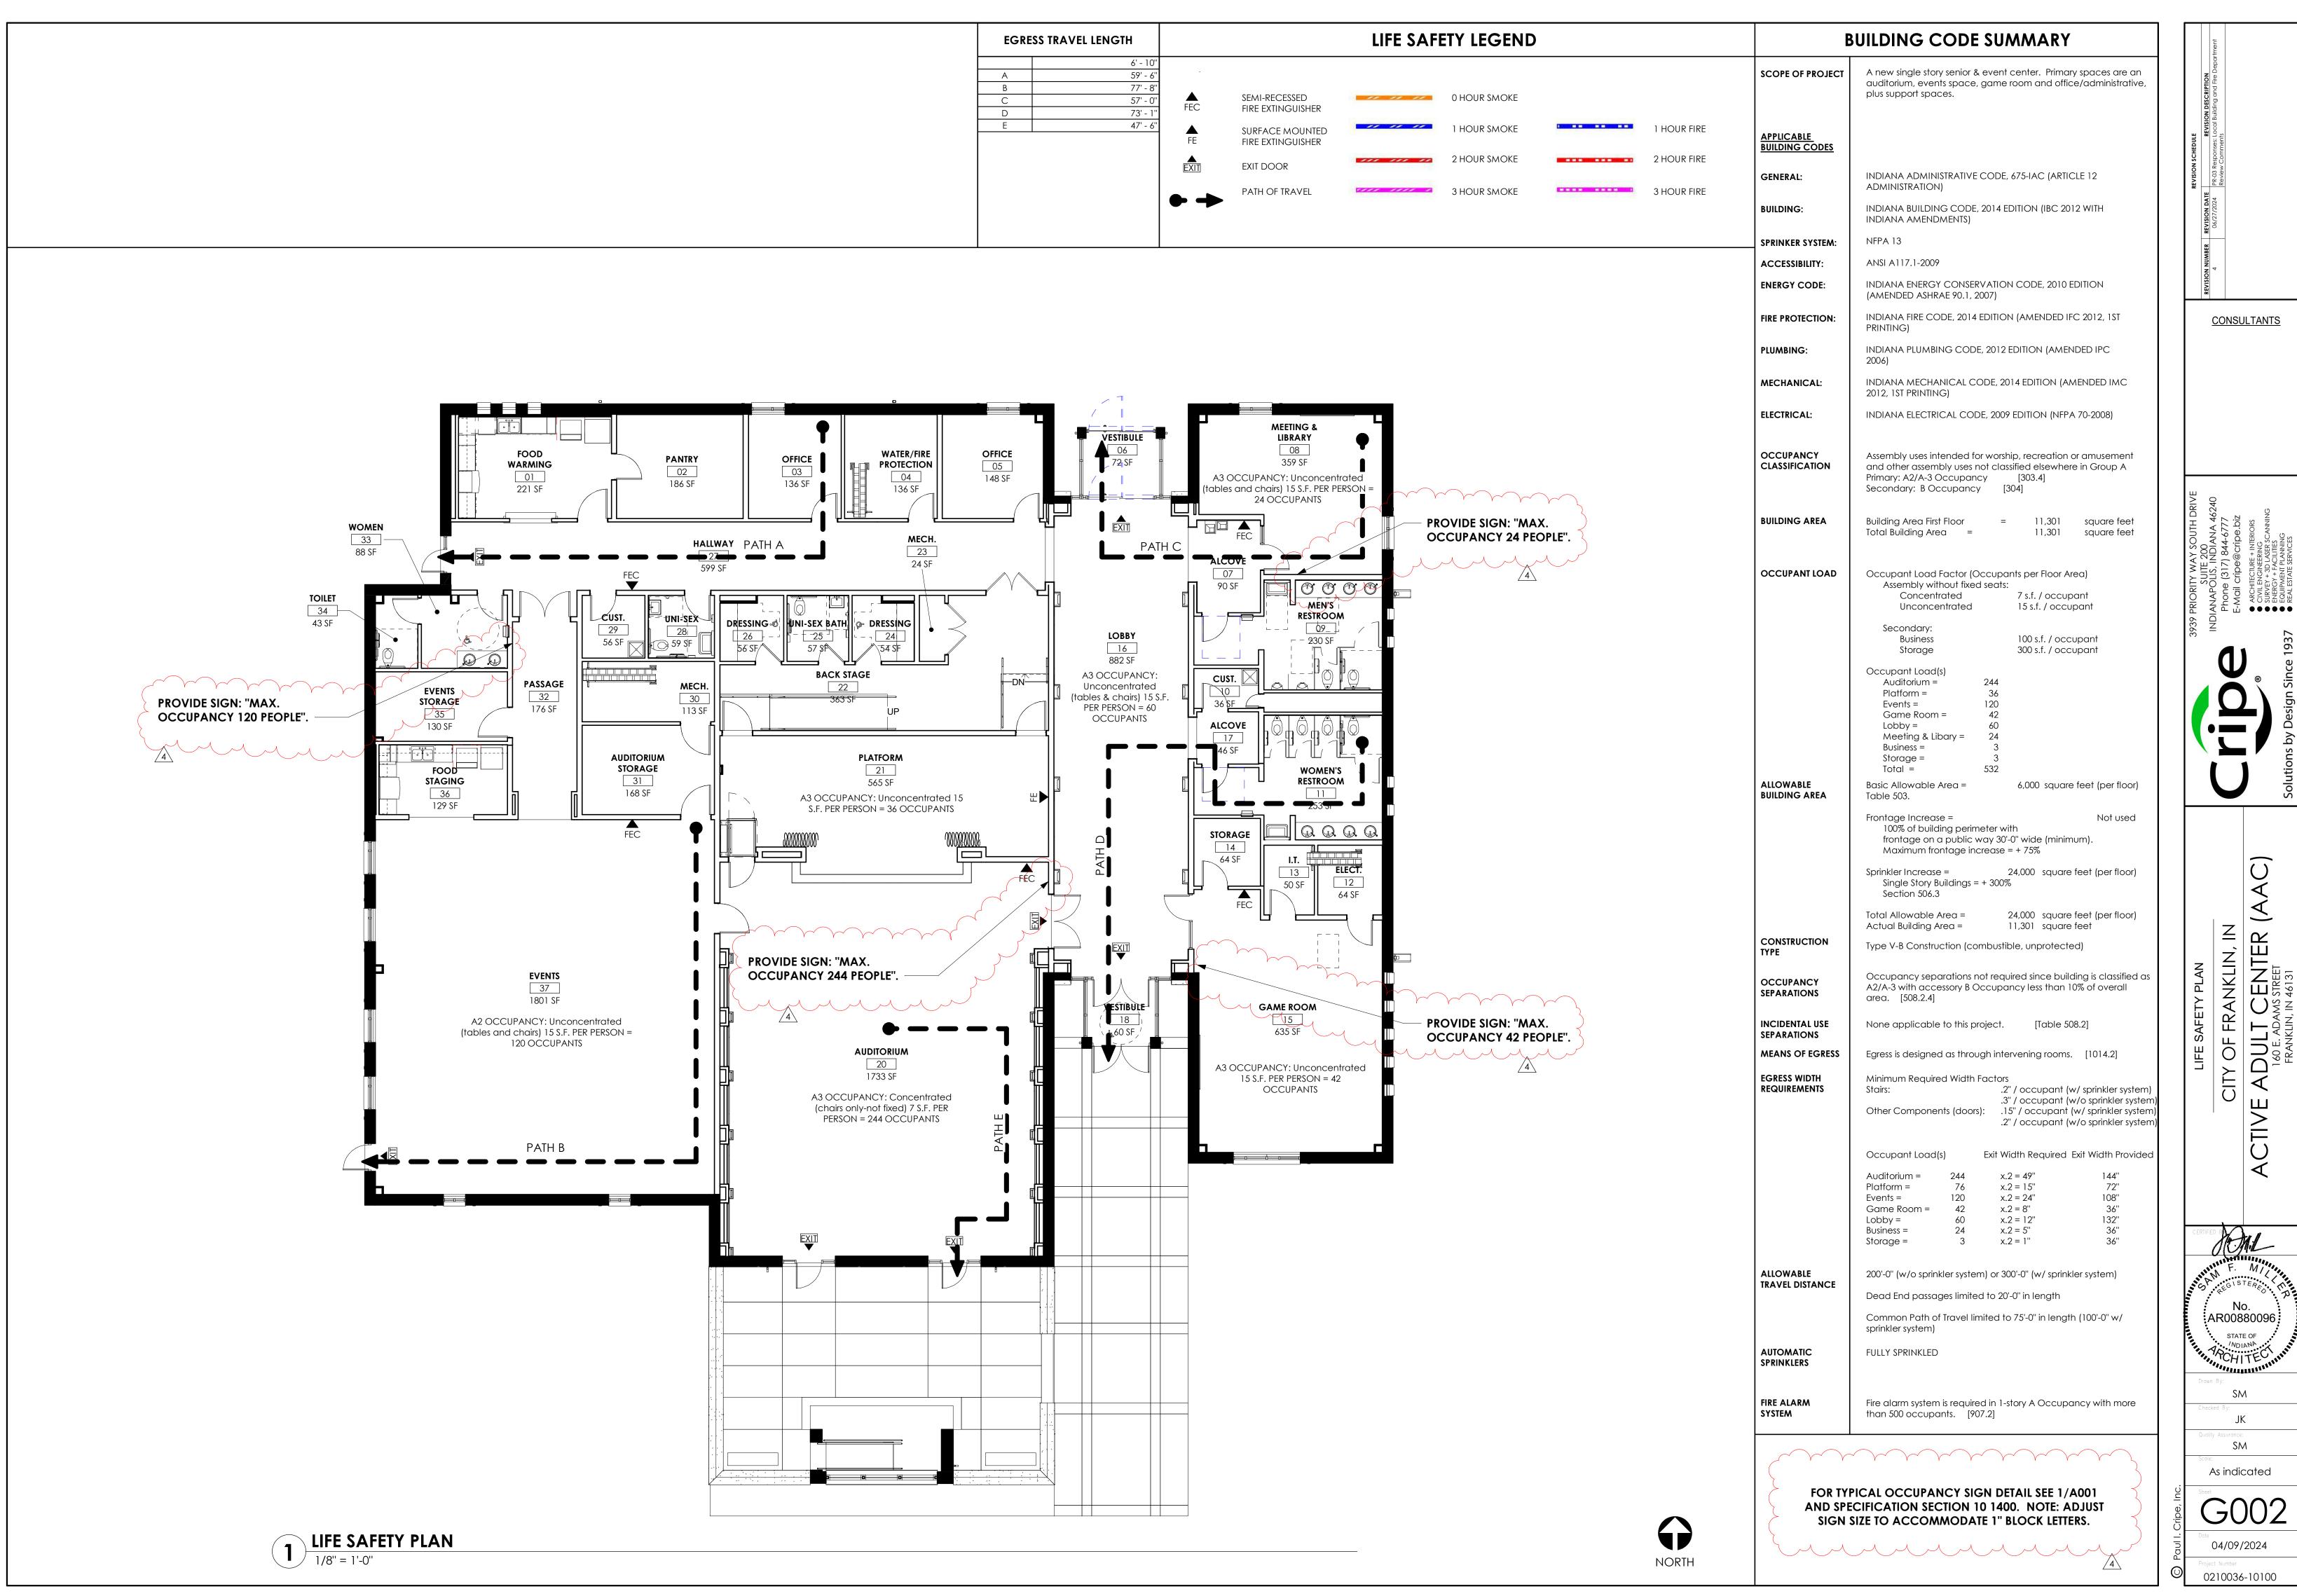

**CONSULTANTS** 

CTIVE


No. AR00880096 STATE OF

SM JK

SM

As indicated

04/09/2024 0210036-10100

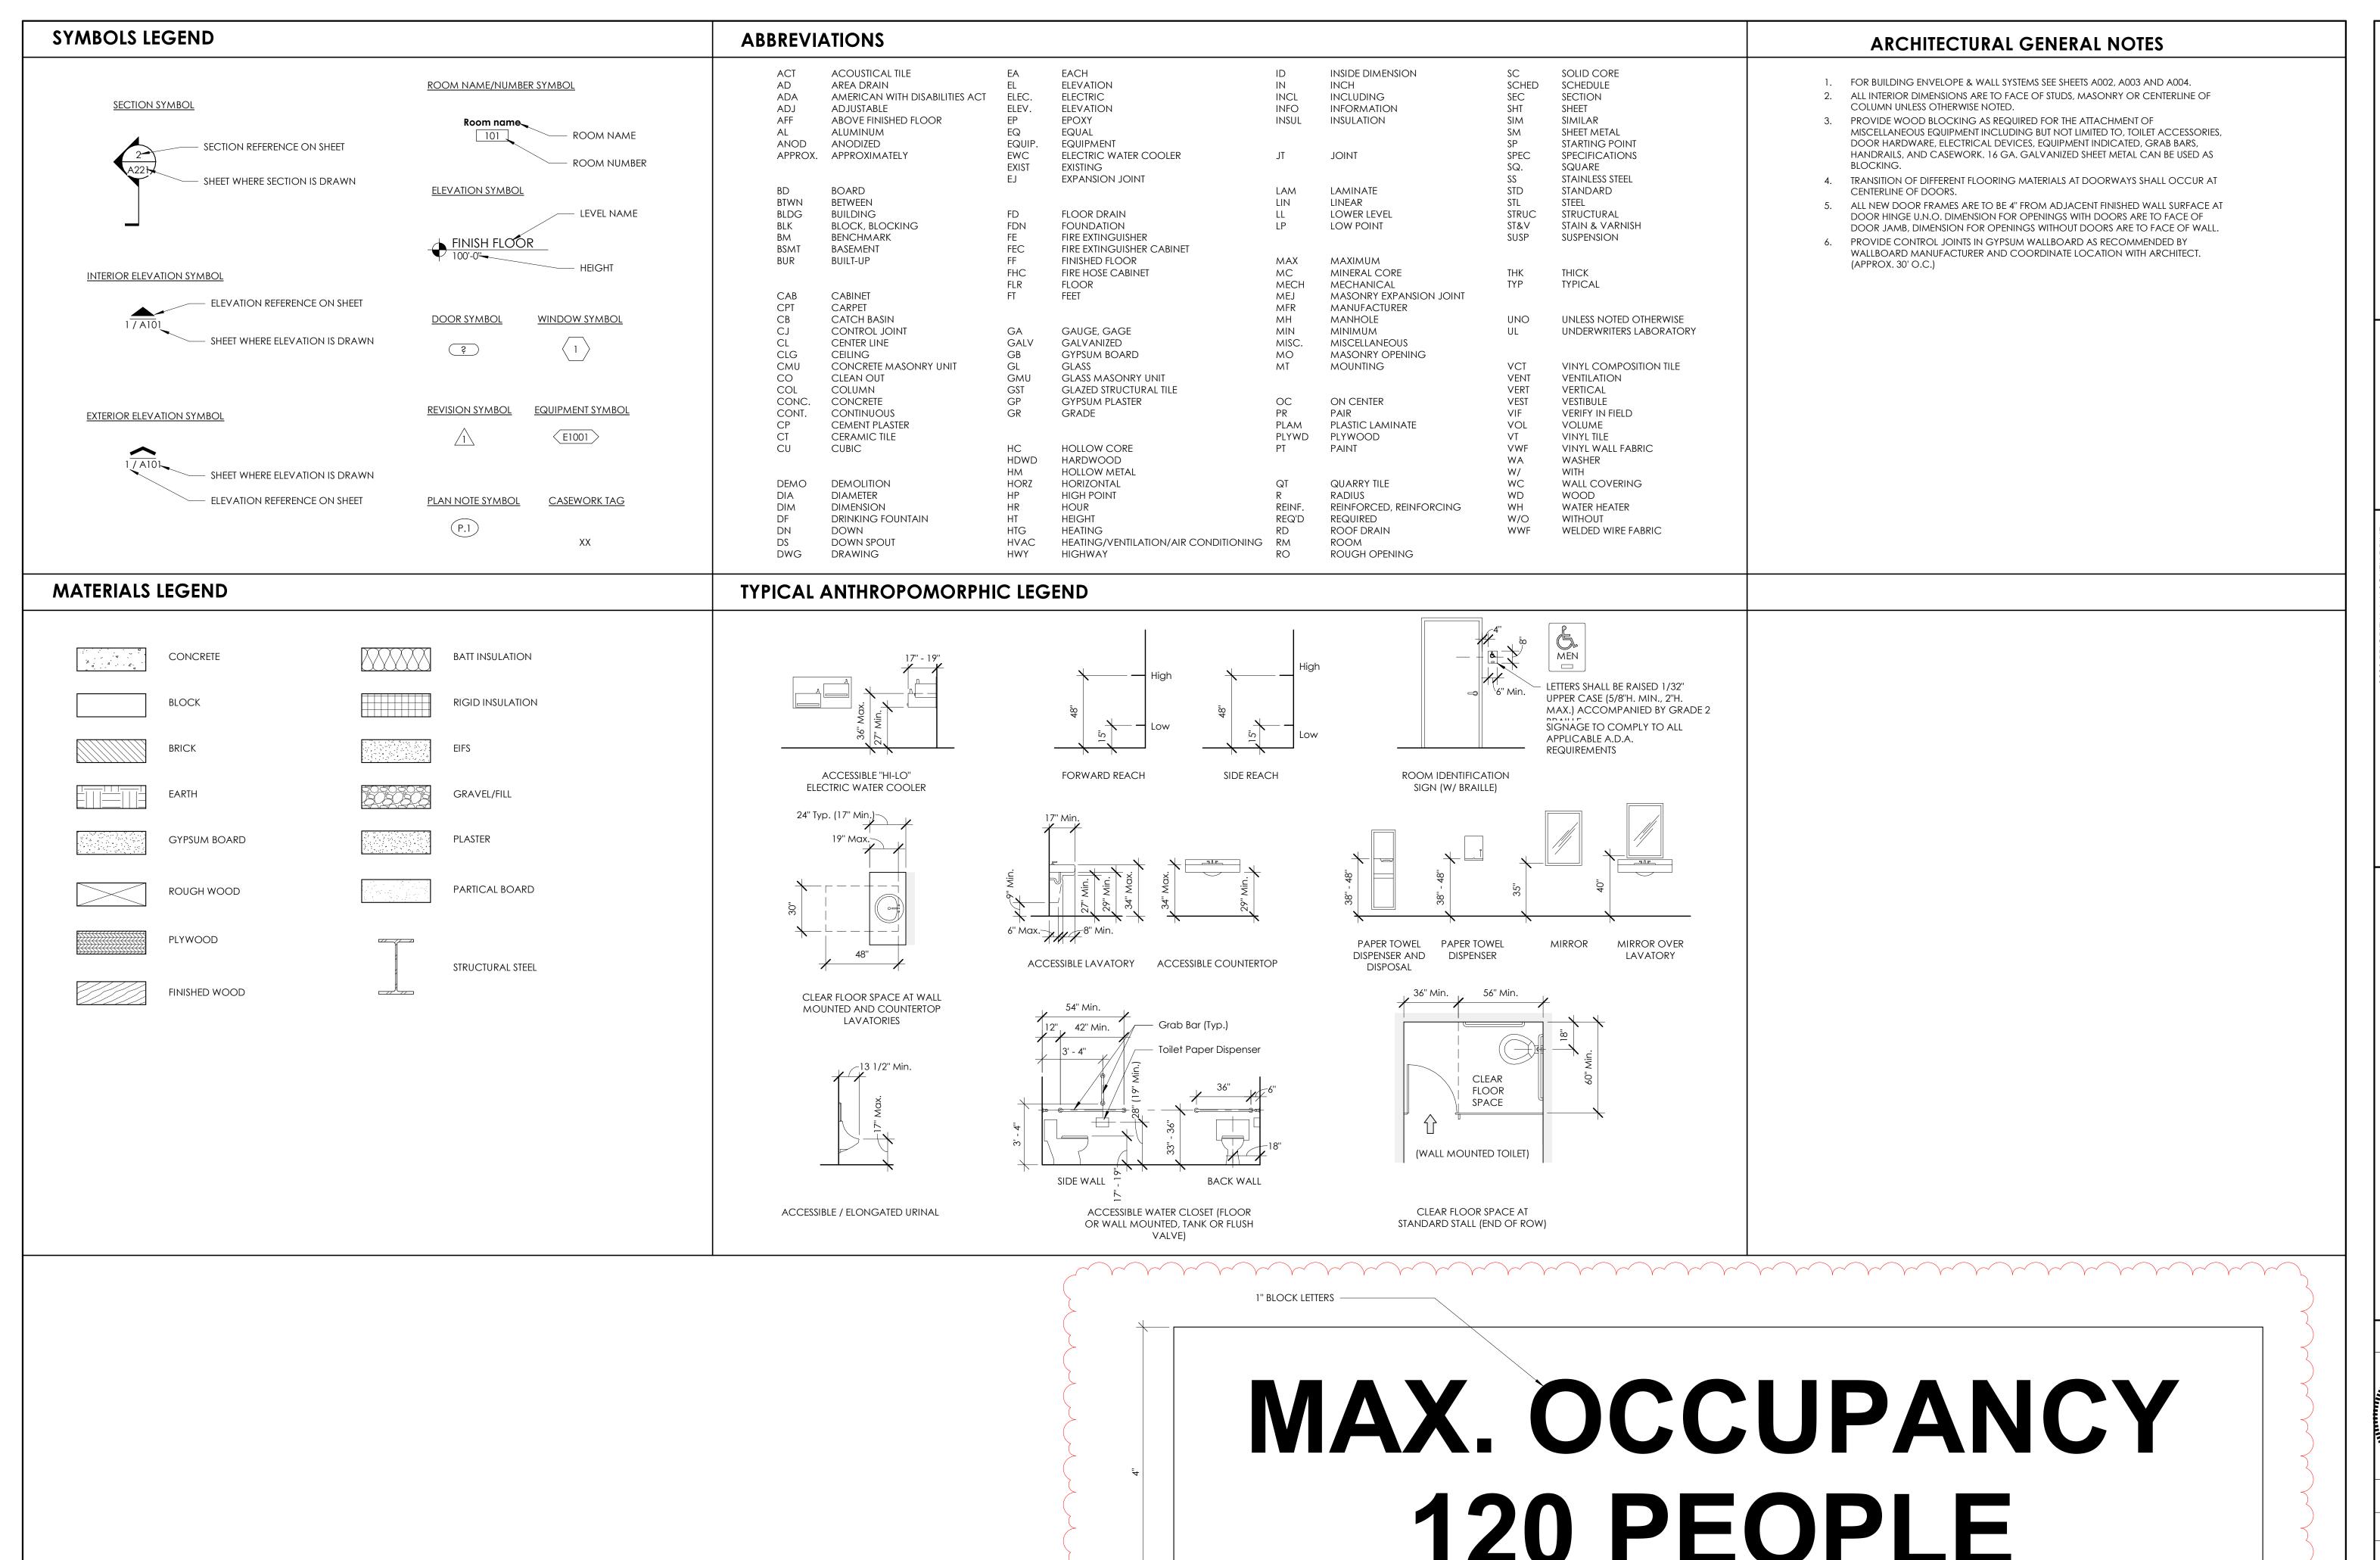

OCCUPANCY SIGN

120 PEOPLE

1' - 3"

As indicated

04/09/2024


KJ

SM

0210036-10100

**CONSULTANTS** 

₹ □ □ ●●●●●

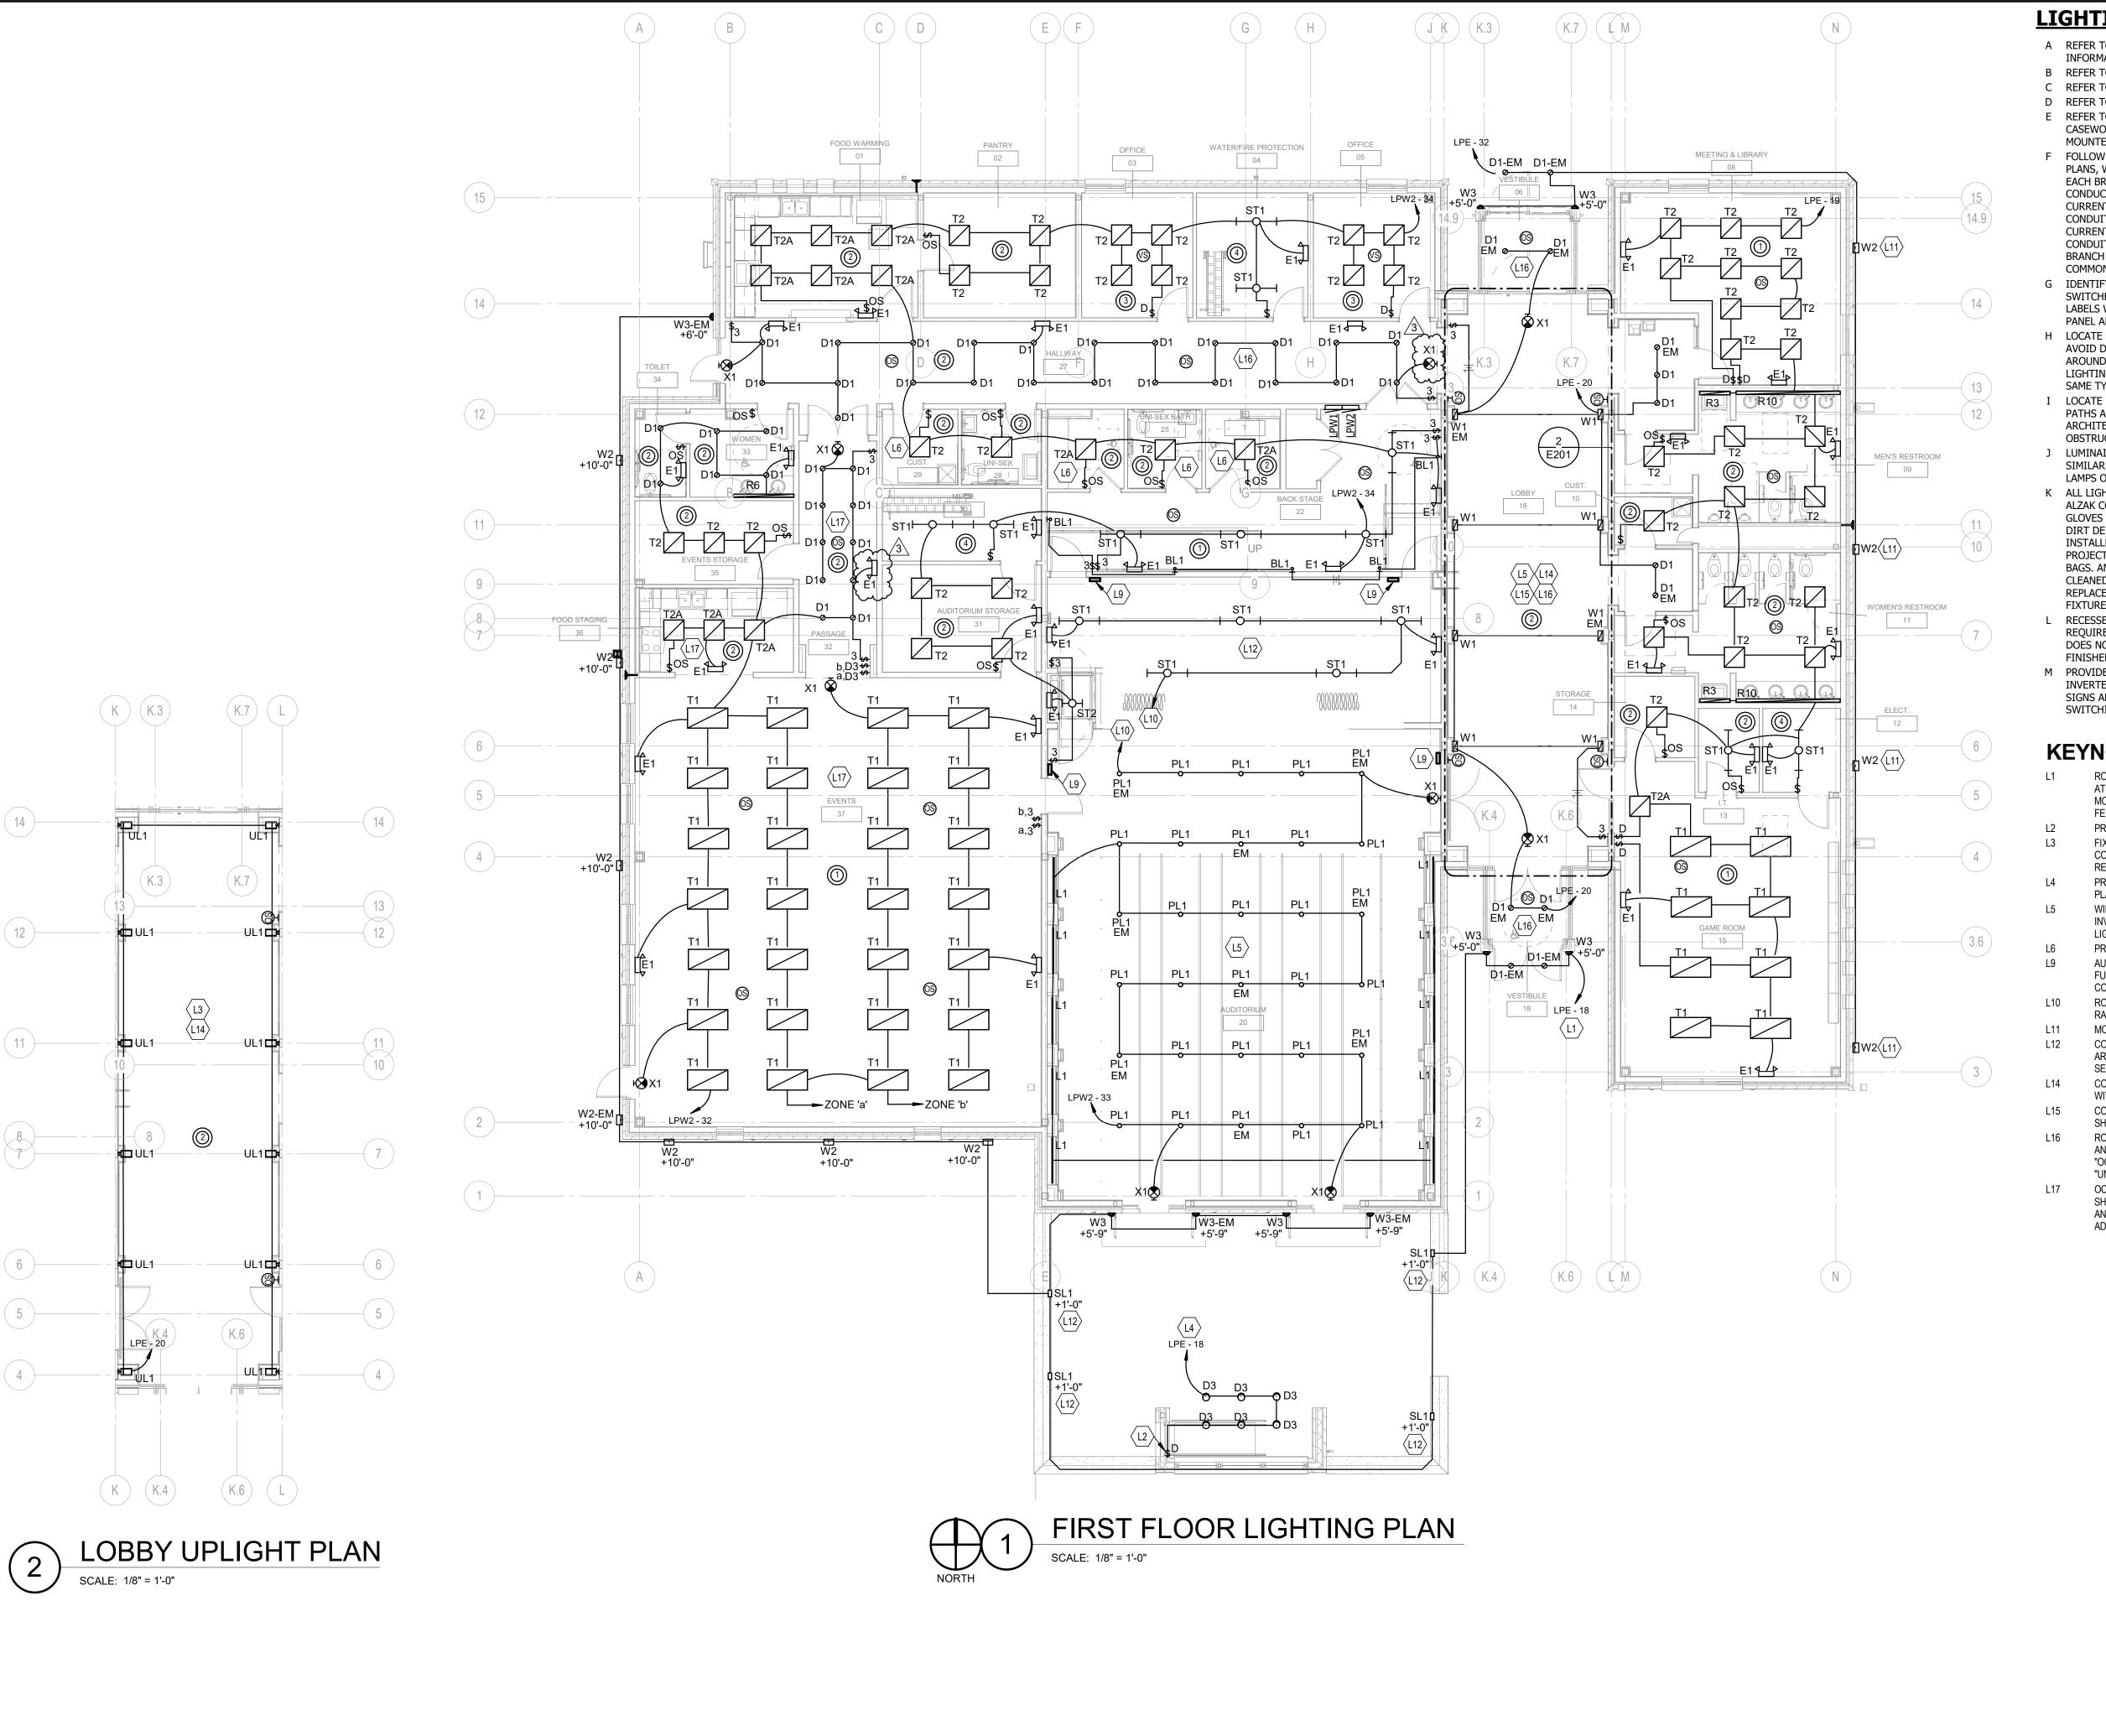

### **LIGHTING GENERAL NOTES**

- A REFER TO SHEET E001 FOR SYMBOLS, ABBREVIATIONS, AND MORE INFORMATION.
- B REFER TO SHEET E701 FOR ONE LINES AND DIAGRAMS.
- C REFER TO SHEET E801 FOR PANELBOARD SCHEDULES.
- D REFER TO SHEET E901-E903 FOR DETAILS.
- E REFER TO THE ARCHITECT'S REFLECTED CEILING PLANS, ELEVATIONS, AND CASEWORK DETAILS FOR EXACT LOCATIONS OF ALL WALL AND CEILING MOUNTED ELECTRICAL DEVICES.
- F FOLLOW BRANCH CIRCUITING LAY-OUT, AS INDICATED ON THE FLOOR PLANS, WITH A MAXIMUM OF THREE (3) BRANCH CIRCUITS PER HOMERUN. EACH BRANCH CIRCUIT SHALL BE PROVIDED WITH A DEDICATED NEUTRAL CONDUCTOR. DEDICATED NEUTRAL CONDUCTORS SHALL BE CONSIDERED CURRENT CARRYING. IF ADDITIONAL CONDUCTORS ARE RAN IN THE SAME CONDUIT WITH THOSE INDICATED, CONTRACTOR SHALL DERATE ALL CURRENT CARRYING CONDUCTORS PER N.E.C. #310.15(B)(3), AND UPSIZE CONDUIT AS REQUIRED PER N.E.C. #300.17 AND ANNEX C. MULTIWIRE BRANCH CIRCUITS AS DEFINED IN N.E.C #100 / 210.4 (CIRCUITS SHARING A COMMON NEUTRAL CONDUCTOR) SHALL NOT BE PERMITTED.
- IDENTIFY THE PANEL AND CIRCUIT NUMBER FOR ALL RECEPTACLES, SWITCHES, ETC. IN AREA OF CONSTRUCTION. PROVIDE CLEAR ADHESIVE LABELS WITH BLACK LETTERING. MARK INSIDES OF ALL DEVICE BOXES WITH PANEL AND CIRCUIT NUMBER.
- H LOCATE CABLEHUNG INDUSTRIAL FIXTURES IN MECHANICAL ROOMS TO AVOID DUCTWORK AND PIPING, TO MAXIMIZE AVAILABLE LIGHT. SPACE AROUND EQUIPMENT, AIR HANDLERS, ETC. TO PROVIDE ADEQUATE LIGHTING TO ALL AREAS OF ROOM. PROVIDE ADDITIONAL FIXTURES OF SAME TYPE AS NEEDED TO FULFILL THIS REQUIREMENT.
- LOCATE EXIT SIGNS FOR MAXIMUM VIEWING AREA TO IDENTIFY EGRESS PATHS AS INDICATED ON PLANS. COORDINATE LOCATIONS SUCH THAT ARCHITECTURAL FEATURES OR EQUIPMENT FROM OTHER TRADES DO NOT OBSTRUCT VIEW.
- J LUMINAIRES INDICATED WITH MULTI-LEVEL SWITCHING SHALL HAVE SIMILAR LAMPS CONTROLLED TOGETHER, I.E. INBOARD AND OUTBOARD LAMPS OR RIGHT AND LEFT HAND LAMPS.
- K ALL LIGHTING FIXTURE LENSES, PARABOLIC LOUVERS, DOWNLIGHTING ALZAK CONES AND "PARACUBE" LOUVERS SHALL BE HANDLED WITH COTTON GLOVES DURING INSTALLATION AND LAMPING TO AVOID FINGERPRINTS OR DIRT DEPOSITS. IT IS PREFERRED THAT FIXTURES BE SHIPPED AND INSTALLED WITH CLEAR PLASTIC BAGS TO PROTECT LOUVERS. AT CLOSE OF PROJECT, AND AFTER CONSTRUCTION AIR FILTERS ARE CHANGED, REMOVE BAGS. ANY LOUVER OR CONE SHOWING DIRT OR FINGER PRINTS SHALL BE CLEANED WITH SOLVENT RECOMMENDED BY THE MANUFACTURER, OR REPLACED AS NECESSARY IN ORDER TO TURN OVER TO THE OWNER NEW FIXTURES AT OCCUPANCY.
- RECESSED LUMINAIRES SHALL BE SECURED SUCH THAT THE FORCE REQUIRED INSERTING LAMPS, TRIMS, LENSES, LOUVERS, OR DOOR FRAMES DOES NOT SHIFT HOUSING. ALL TRIMS SHALL BE COMPLETELY FLUSH WITH FINISHED CEILINGS AT COMPLETION OF CONSTRUCTION.
- M PROVIDE UNSWITCHED CONDUCTOR TO ALL EXIT SIGNS, EMERGENCY INVERTER BATTERY PACKS, AND NIGHT LIGHTS AS REQUIRED. CIRCUIT EXIT SIGNS AND EMERGENCY BATTERY PACKS TO LOCAL CIRCUIT AHEAD OF ANY SWITCHING.

### **KEYNOTES**

- ROUTE CIRCUIT THROUGH LIGHTING CONTACTOR AND PHOTOCELL FOR ON AT DUSK/OFF AT DAWN OPERATION. REFER TO DETAILS ON SHEET E901 FOR MORE INFORMATION. WIRING SHOWN FOR CIRCUITING PURPOSES ONLY. FEEDER AND CONDUIT SHALL BE ROUTED BELOW GRADE TO THE BUILDING. PROVIDE LOCKABLE WEATHERPROOF COVER FOR SWITCH.
- FIXTURES ON THIS PLAN WIRED THROUGH LOBBY 16 LOCAL LIGHTING CONTROLS. LOCATE FIXTURES FLUSH ON TOP OF BULKHEAD/PILASTER. REFER TO ARCHITECTURAL PLANS FOR EXACT MOUNTING HEIGHTS.
- PROVIDE NON-PHOTOCELL CONTROLLED CONDUCTORS TO FIXTURES IN PLATFORM OVERHANG.
- WIRE EMERGENCY SIDE OF FIXTURES IN THIS AREA THROUGH LIGHTING INVERTER, ELP-1. PROVIDE EMERGENCY AUTOMATIC TRANSFER DEVICE FOR LIGHTING CONTROLS.
- PROVIDE FIXTURES IN THIS SPACE WITH A DRYWALL GRID ADAPTER. AUDITORIUM AND PLATFORM MASTER LIGHTING CONTROL STATION
- CONDUIT FROM CONTROL STATION TO DIMMING RACK. ROUTE AUDITORIUM AND PLATFORM LIGHTING CIRCUITS THROUGH DIMMER
- MOUNT LIGHT FIXTURE AT 7'-4" AFF TO BOTTOM OF FIXTURE
- COORDINATE MOUNTING HEIGHT OF FIXTURES IN THIS AREA WITH ARCHITECT. ENSURE FIXTURES ARE NOT VISIBLE FROM AUDITORIUM COORDINATE MOUNTING HEIGHT OF FIXTURES AND CONTROLS IN THIS AREA
- WITH ARCHITECT PRIOR TO ROUGH-IN.
- CONNECT LIGHTING CONTROLS IN THIS AREA TO UPLIGHT FIXTURES, 'UL1' SHOWN ON 'LOBBY UPLIGHT PLAN' ON THIS SHEET. ROUTE LIGHTING FIXTURES IN THIS AREA THROUGH LIGHTING CONTACTOR
- AND TIME CLOCK. FIXTURES TO BE CONTROLLED BY LOCAL SWITCH DURING "OCCUPIED" HOURS, CONTROLLED BY OCCUPANCY SENSOR DURING "UNOCCUPIED" HOURS.
- OCCUPANCY SENSORS IN PASSAGE 32, FOOD STAGING 36, AND EVENTS 37 SHALL OPERATE AS ONE 'OCCUPIED' SPACE I.E. AN OCCUPANCY SENSOR IN ANY OF THE THREE SPACES SHALL CONTROL ALL THREE ROOMS. PROVIDE ADDITIONAL POWER PACKS AND WIRING AS REQUIRED.

**CONSULTANTS** 

₹ □ □ ●●●●●

CENTER

FRANKLIN


JNS

JAE 1/8" = 1'-0"

DF

E20 04/09/2024

IFAC23

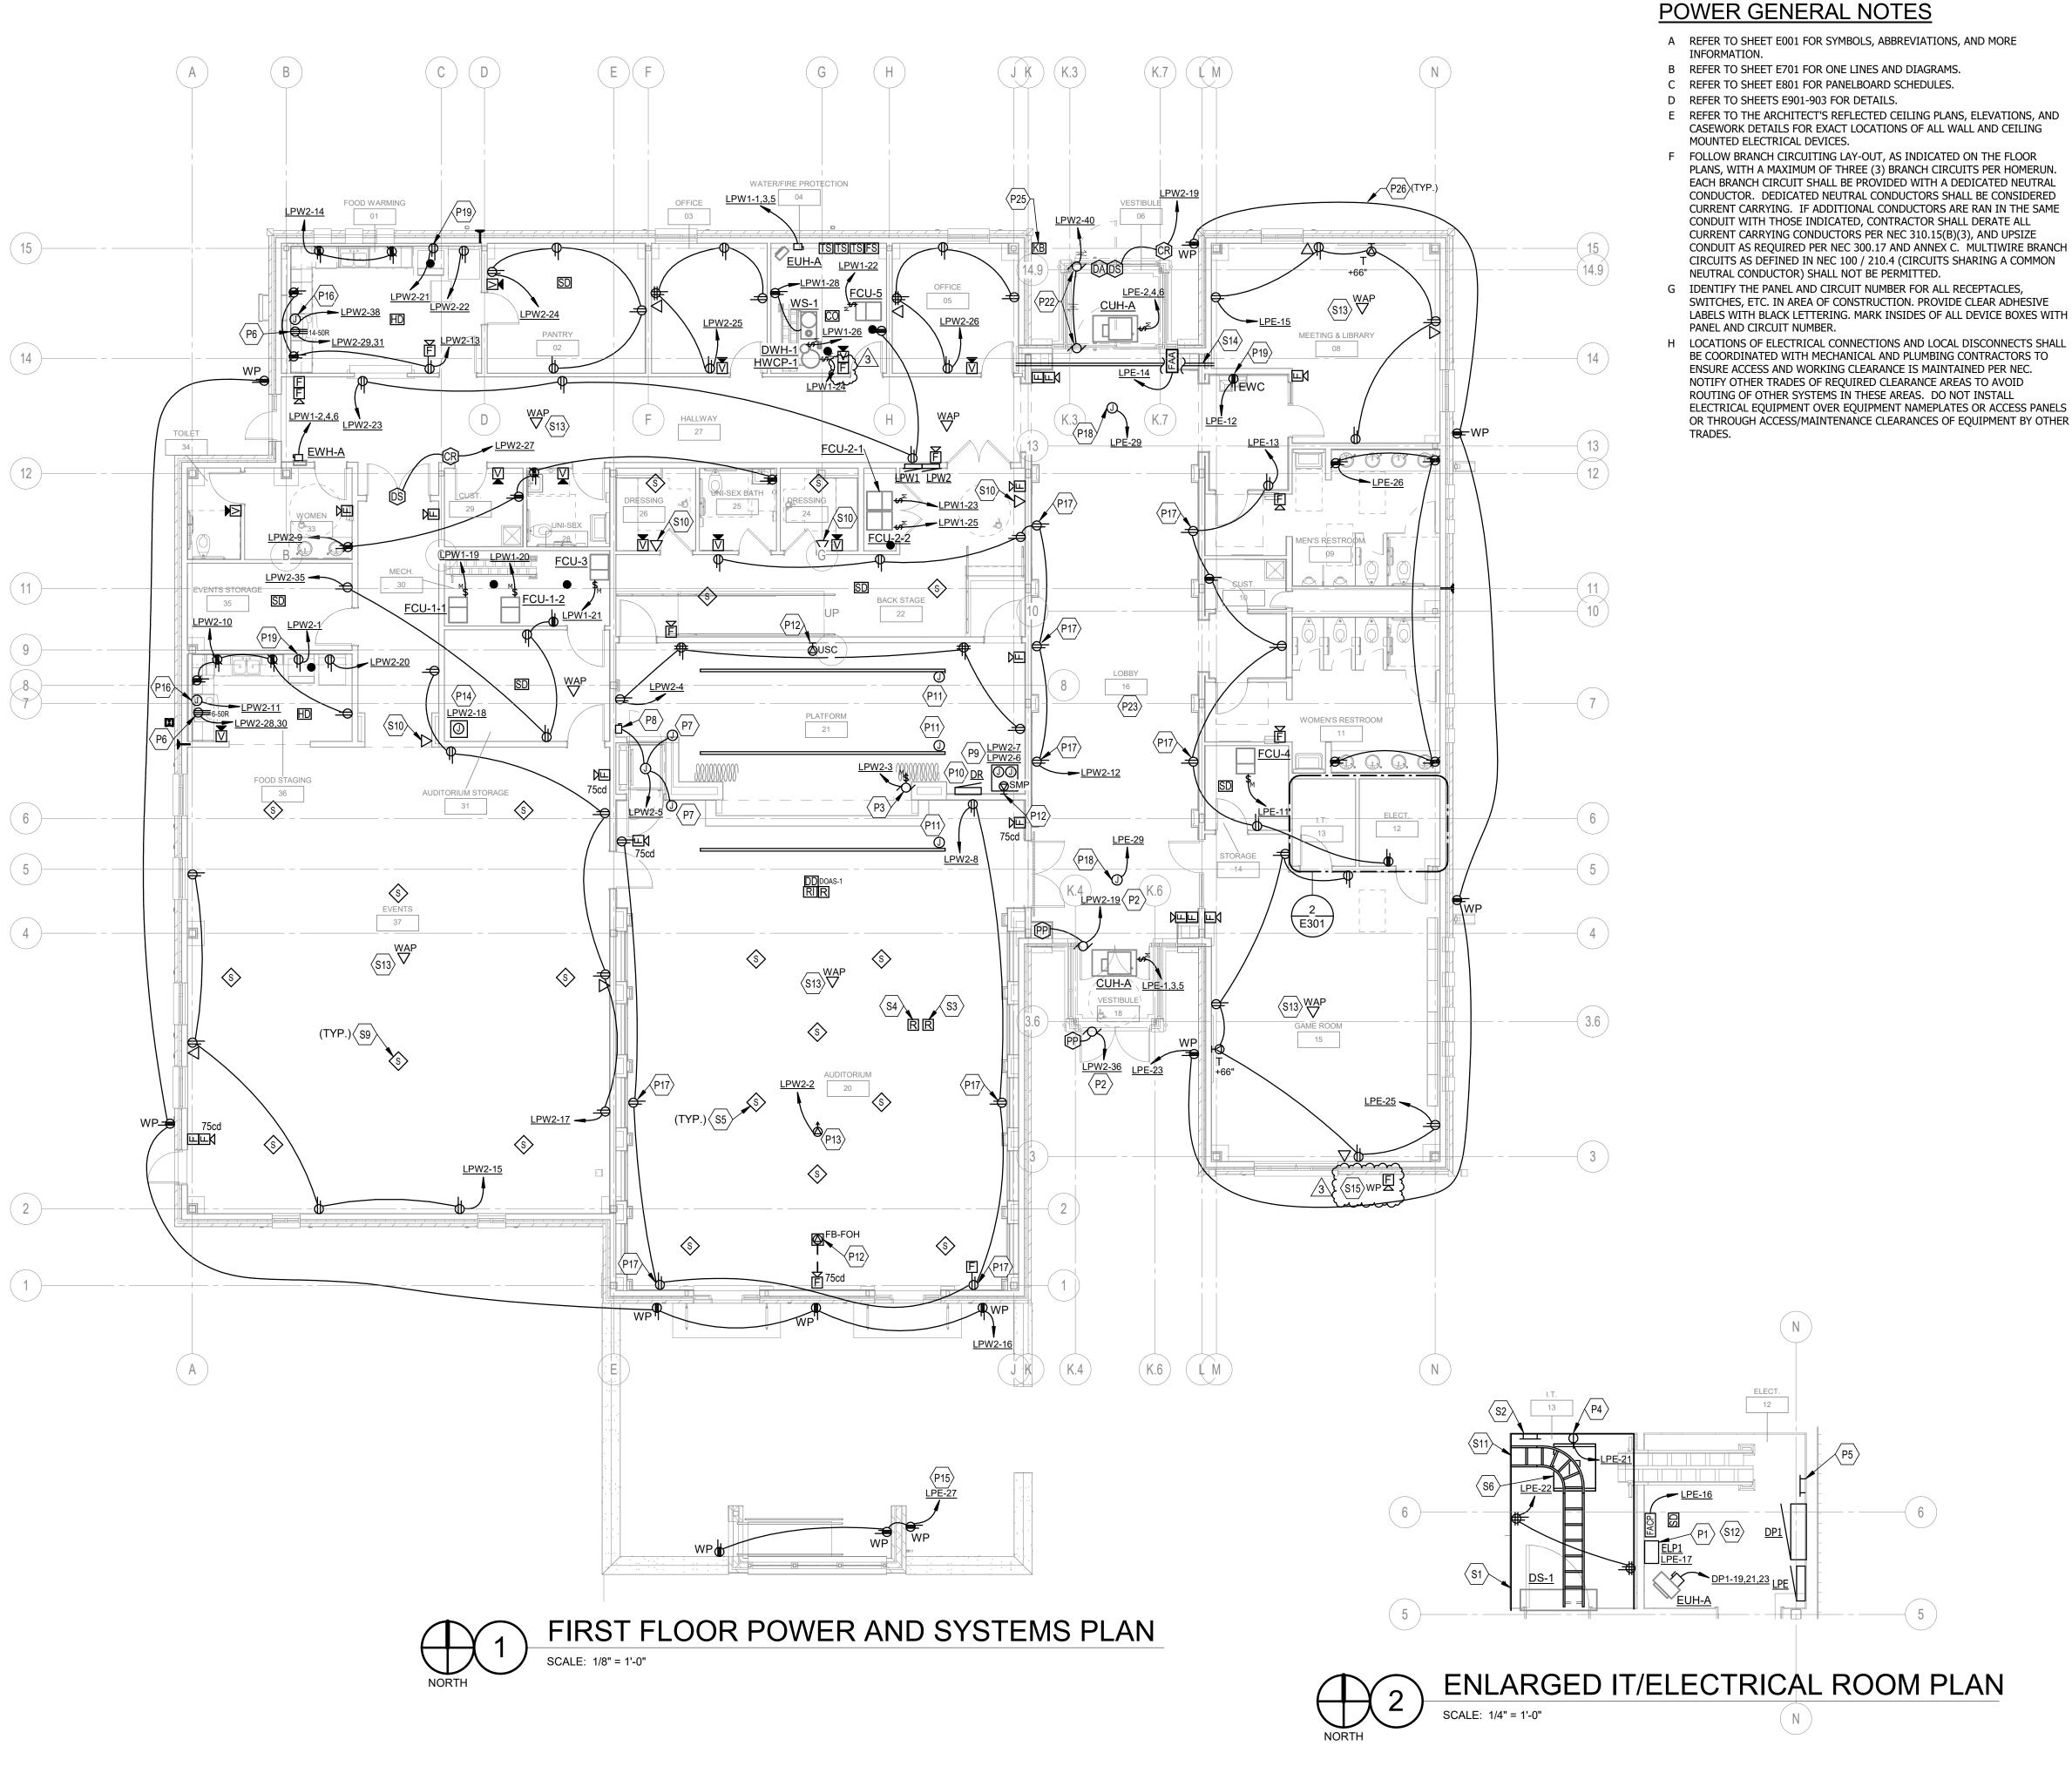

- PROVIDE CONNECTION AND TOGGLE SWITCH FOR AUTOMATIC DOOR OPERATOR AND PUSH PLATES FOR DOOR ACTUATION. WIRE AND INSTALL PER MANUFACTURER'S RECOMMENDATIONS. COORDINATE MOUNTING LOCATIONS FOR PUSH PLATES WITH ARCHITECT PRIOR TO ROUGH-IN. EACH PUSH PLATE SHALL OPERATE INTERIOR AND EXTERIOR DOOR. PROVIDE
- MOTORIZED PROJECTOR SCREEN FURNISHED BY THEATRICAL CONTRACTOR, INSTALLED BY CONTRACTOR. PROVIDE POWER CONNECTION TO MOTORIZED PROJECTOR SCREEN ON STAGE SIDE OF PROSCENIUM. WIRE AND INSTALL PER MANUFACTURER RECOMMENDATIONS AND PROVIDE TOGGLE SWITCH FOR UNIT DISCONNECTING MEANS. PROVIDE (1) 1" CONDUIT FROM AV RACK TO MOTORIZED PROJECTOR SCREEN LOCATION. LOW VOLTAGE WIRING FURNISHED BY OTHERS, INSTALLED BY CONTRACTOR, TERMINATED BY OTHERS. COORDINATE EXACT LOCATION OF PROJECTOR SCREEN WITH ARCHITECT PRIOR TO ROUGH-IN.
- PROVIDE A NEMA 5-30R RECEPTACLE FOR DATA RACK IN THIS SPACE. COORDINATE EXACT REQUIREMENTS WITH OWNER PRIOR TO ROUGH-IN AND
- PROVIDE MAIN GROUNDING BUSBAR. REFER TO DETAIL 4 ON SHEET ES102 AND DETAIL 2 ON SHEET E901.
- PROVIDE RANGE WITH A UL LISTED, 4-WIRE, 250V, 50A RANGE POWER SUPPLY CORD. CORD SHALL BE TYPE SRD OR SRDT WITH UL LISTED STRAIN
- PROVIDE (1) 1" CONDUIT FROM LIFT CONTROL PANEL TO RECESSED WALL
- 30A, NON-FUSED DISCONNECT IN ACCESSIBLE LOCATION. COORDINATE EXACT LOCATION AND REQUIREMENTS WITH EQUIPMENT SUPPLIER AND ARCHITECT PRIOR TO BEGINNING WORK.
- COORDINATE EXACT LOCATION AND CONNECTION REQUIREMENTS WITH AV SUPPLIER PRIOR TO ROUGH-IN.
- PROVIDE (3) 120V, 20A CIRCUITS FROM STAGE DIMMING RACK TO RIGGING CONNECTION POINT. PROVIDE (1) 1" CONDUIT FROM STAGE DIMMING RACK TO RIGGING CONNECTION POINT FOR LOW VOLTAGE WIRING. COORDINATE EXACT LOCATIONS AND CONNECTION REQUIREMENTS WITH AV SUPPLIER. PROVIDE (1) 1" CONDUIT WITH PULL STRING AND (1) 3/4" CONDUIT WITH (2)
- SETS OF (2) #12, #12EG FROM STAGE DIMMER RACK TO ROUGH-IN FOR POWER AND A/V DEVICES, SIZED PER FACEPLATE CONNECTION REQUIREMENTS. FACE PLATE PROVIDED BY CONTRACTOR, REFER TO SHEET E903 FOR FACE PLATE CONNECTIONS.
- CEILING MOUNTED PROJECTOR PROVIDED BY OTHERS. PROVIDE CEILING MOUNTED DUPLEX RECEPTACLE AND (1) 1" CONDUIT FROM DATA RACK FEEDING THIS SPACE TO CEILING SPACE ABOVE PROJECTOR FOR LOW VOLTAGE WIRING. COORDINATE EXACT MOUNTING LOCATION WITH
- EVENTS SPACE AV RACK FURNISHED BY SOUND SYSTEM CONTRACTOR, INSTALLED BY CONTRACTOR. PROVIDE (1) 120V, 20A CIRCUITS TO AV RACK.
- PROVIDE ON/OFF TOGGLE SWITCH IN ELECTRICAL ROOM. ROUTE PATIO
- PROVIDE 120V CONNECTION TO STOVE HOOD. COORDINATE EXACT CONNECTION REQUIREMENTS WITH EQUIPMENT SUPPLIER.
- LOCATE RECEPTACLE 4" AFF. MOUNTED HORIZONTAL IN FLOOR MOULDING. PROVIDE A JUNCTION BOX WITH COVER MOUNTED IN LOBBY CEILING FOR
- INDICATED PANEL. PROVIDE GROUND FAULT PROTECTION AT CIRCUIT BREAKER LEVEL.
- PROVIDE 120V CONNECTION TO AUTOMATIC DOOR. COORDINATE EXACT CONNECTION REQUIREMENTS WITH EQUIPMENT SUPPLIER.
- LOBBY SPACE. ALL CONDUIT AND WIRE SHALL BE CONCEALED. COORDINATE EXACT ROUTING WITH OTHER TRADES AND ARCHITECT.
- LOCATION FOR KNOX BOX WITH LOCAL FIRE DEPARTMENT AND PROVIDE
- CIRCUITS SHALL NOT BE RUN OUTSIDE OF THE BUILDING AS DEPICTED ON
- PROVIDE 0.75" A/C GRADE PLYWOOD WITH LAYER OF FIRE INTUMESCENT
- FITINGS. REFER TO DETAIL 6 ON SHEET E901 FOR ADDITIONAL INFORMATION. PROVIDE FIRE ALARM SYSTEM INTERLOCK WITH AUDITORIUM SOUND
- PROVIDE FIRE ALARM SYSTEM INTERLOCK WITH AUDITORIUM LIGHTING CONTROLS. AUDITORIUM LIGHTS TO TURN ON TO FULL BRIGHTNESS UPON
- FIRE ALARM ACTIVATION. SPEAKERS IN AUDITORIUM FURNISHED BY THEATRICAL CONTRACTOR, INSTALLED BY CONTRACTOR. PROVIDE (1) 1" CONDUIT BETWEEN CLOUDS, MOUNTED TIGHT TO STRUCTURE, FOR LOW VOLTAGE WIRING PATHWAY. COORDINATE WITH MECHANICAL DUCTWORK TO KEEP CONDUIT ACCESSIBLE. PROVIDE (1) 1" CONDUIT STUBBED UP FROM DATA RACK TO AUDITORIUM CEILING SPACE FOR SPEAKER WIRING. CONTRACTOR TO PULL
- SPEAKERS IN EVENT SPACE FURNISHED BY SOUND SYSTEM CONTRACTOR, INSTALLED BY CONTRACTOR. PROVIDE (1) 1" CONDUIT FROM EVENTS AV RACK TO ABOVE EVENTS SPACE ACCESSIBLE CEILING. CONTRACTOR TO PULL ASSOCIATED WIRING. REFER TO EAV SERIES SHEETS FOR FURTHER INFORMATION.
- PROVIDE ONE-GANG BOX FOR VOLUME CONTROL STATION. PROVIDE (1) 1" CONDUIT FROM VOLUME CONTROL BOX TO SPEAKERS IN THIS AREA AND FROM VOLUME CONTROL BOX TO AV RACK SERVING THIS AREA. COORDINATE EXACT LOCATION OF VOLUME CONTROL BOX WITH ARCHITECT PRIOR TO ROUGH-IN.
  - PROVIDE 12"x4" LADDER CABLE TRAY.
- CONTRACTOR SHALL PERFORM EMERGENCY RESPONDER RADIO COVERAGE TEST. IF NECESSARY PER AHJ REQUIREMENTS FOR COVERAGE, PROVIDE ERRS SYSTEM. REFER TO SPECIFICATION SECTION 285129 FOR
- COORDINATE EXACT LOCATION AND REQUIREMENTS WITH OWNER. REFER TO DETAIL 7 ON SHEET E902.
- BUSHINGS ON END THROUGH SOFFIT SPACE FOR LOW VOLTAGE WIRING. /3/ PROWIDE PATHWAY FROM CONDUIT TO IT ROOM PROVIDE EXTERIOR HORN/STROBE FOR WATER FLOW ALARM. COORDINATE EXACT LOCATION OF DEVICE WITH ARCHITECT AND SERVICING FIRE

**KEYNOTES** 

PROVIDE A 18"W X 25"H X 8"D 600VA LIGHTING INVERTER, DUAL LITE LG SERIES OR EQUAL, WITH 90 MINUTE BACK UP AND A 10 YEAR VRLA SEALED BATTERY. INVERTER SHALL BE WALL MOUNTED AND UTILITY A TYPE S BATTERY. PROVIDE 120V INPUT AND OUTPUT. INVERTER MUST BE RATED TO HANDLE IN-RUSH CURRENT BEYOND NORMAL DEMAND OF CONNECTED

TIME DELAY ON DOORS SO THAT ONLY ONE SET IS OPEN AT A TIME.

COORDINATE EXACT OPERATION WITH ARCHITECT

PROVIDE ACCORDINGLY.

JUNCTION BOXES FOR LIFT CALL STATIONS. COORDINATE EXACT LOCATION AND REQUIREMENTS WITH EQUIPMENT SUPPLIER AND ARCHITECT PRIOR TO BEGINNING WORK.

PROVIDE A 120V. 20A CIRCUIT TO PLATFORM LIFT CONTROL PANEL, PROVIDE

AUDITORIUM AV RACK FURNISHED BY THEATRICAL CONTRACTOR, INSTALLED BY CONTRACTOR. PROVIDE (2) 120V, 20A CIRCUITS TO AV RACK.

DIMMING RACK AND DIMMING MODULES FURNISHED BY THEATRICAL CONTRACTOR, INSTALLED BY CONTRACTOR.

STAGE LIGHTING RIGGING PROVIDED BY THEATRICAL CONTRACTOR.

ARCHITECT PRIOR TO ROUGH-IN.

COORDINATE EXACT LOCATION AND CONNECTION REQUIREMENTS WITH AV SUPPLIER PRIOR TO ROUGH-IN.

PLATFORM RECEPTACLE CIRCUIT THROUGH SWITCH.

FUTURE DESTRATIFICATION FANS. PROVIDE 20A, 120V CIRCUIT FROM

NO CONDUIT OR WIRE SHALL BE ROUTED EXPOSED IN EXPOSED CEILING

PROVIDE 120V CONNECTION FOR FIREMANS KNOX BOX. COORDINATE EXACT

BRANCH CIRCUIT SHOWN FOR DIAGRAMMATIC PURPOSES ONLY. BRANCH

PROVIDE TELECOMM GROUNDING BUSBAR WITH ALL COMPRESSION

SYSTEM. AUDITORIUM SOUND SYSTEM TO TURN OFF UPON FIRE ALARM

ASSOCIATED WIRING. REFER TO EAV SERIES SHEETS FOR FURTHER

DATA RACK PROVIDED BY OWNER.

ADDITIONAL INFORMATION.

PROVIDE PATHWAY TO OWNER PROVIDED WIRELESS ACCESS POINT.

PROVIDE (2) 2" CONDUITS, STACKED VERTICALLY, WITH PULL STRINGS AND DEPARTMENT.

JNS

As indicated

DF

JAE

NKLIN

**CONSULTANTS** 

•••••

E30 04/09/2024

IFAC23